



# NE ALPINE AVENUE IMPROVEMENTS


CITY OF McMINNVILLE  
YAMHILL COUNTY, OREGON  
DECEMBER 2016

As-built Drawings



**AAKEN**  
**CORPORATION**  
Electrical Contractors


OREGON LAW REQUIRES YOU TO FOLLOW RULES ADOPTED BY THE OREGON UTILITY NOTIFICATION CENTER. THOSE RULES ARE SET FORTH IN OAR 952-001-0010 THROUGH OAR 952-001-0090. YOU MAY OBTAIN COPIES OF THOSE RULES BY CALLING THE CENTER. THE TELEPHONE NUMBER FOR THE OREGON UTILITY CENTER IS 1-800-332-2344

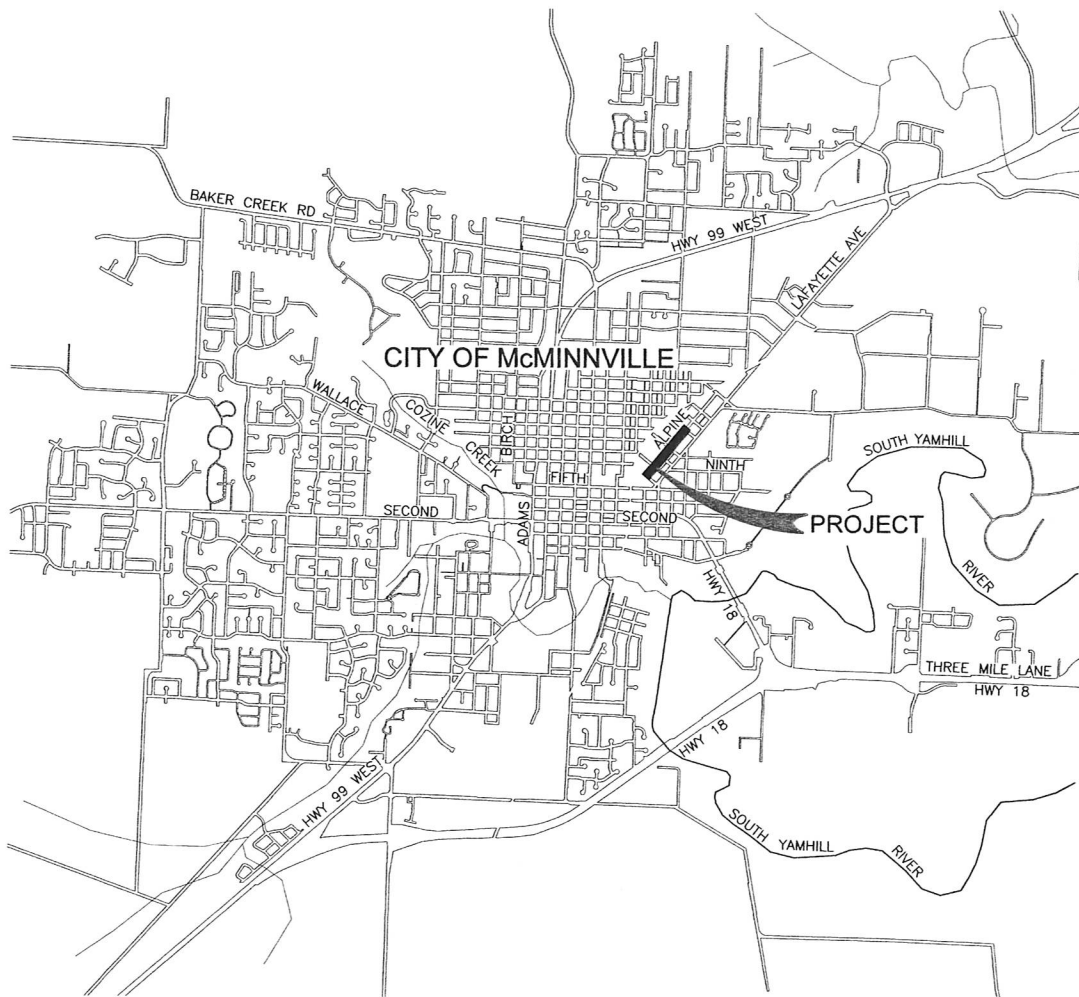

LOCATION MAP  
NOT TO SCALE

## BASE BID INDEX OF SHEETS ("FESTIVAL DISTRICT")

GN100	COVER SHEET AND INDEX
GN101	LEGEND, ABBREVIATIONS, AND STANDARD DETAILS LIST
GN102	GENERAL CONSTRUCTION NOTES
GN103	KEY MAP
GN104	FESTIVAL DISTRICT CONTEXT
DT101-DT102	ROADWAY TYPICAL SECTIONS
DT103-DT104	ROADWAY DETAILS
DT105	PLAIN CONCRETE PAVEMENT - DOWELED
DT106	ISOLATION JOINT DETAILS
DT107	STORM DRAINAGE DETAILS
TC101-TC103	TRAFFIC CONTROL PLAN
S101-S106	EXISTING CONDITIONS
D101	DEMOLITION PLAN
C101-C103	ROADWAY PLAN
J101-J103	JOINTING PLAN
GR101-GR103	GRADING PLAN
SD101-SD104	STORM PLAN AND PROFILE
UT101	UTILITY PLAN
EC101	EROSION CONTROL PLAN
SU101-SU103	SURFACING PLAN
ST101-ST103	STREETSCAPE PLAN
ST301	PLANTER DETAILS
ST302	BENCH DETAILS
ST303	PICNIC TABLE DETAILS
ST304	BRIDGE DETAILS
ST305	FENCE DETAILS
ST306	BOLLARD DETAILS
IR101	IRRIGATION PLAN
IR301-IR302	IRRIGATION DETAILS
PL101-PL103	PLANTING PLAN
PL301-PL302	PLANTING DETAILS
T101-103	STEEL STRUCTURE PLANS
T301-302	STEEL STRUCTURE DETAILS
TS100	TRELLIS STRUCTURE KEY PLAN & NOTES
TS101	TRELLIS 1 PLAN AND ELEVATION
TS102	TRELLIS 2 PLAN AND ELEVATION
TS103	TRELLIS 3 PLAN AND ELEVATION
TS104	TRELLIS 5 PLAN AND ELEVATION
TS105	TRELLIS 6 PLAN AND ELEVATION
TS301-302	FRAMING DETAILS
TF101-103	TRELLIS STRUCTURE FOUNDATION PLAN
TF301	TRELLIS STRUCTURE DETAILS
IL101	LIGHTING PLAN
IL102	LIGHT POLE TABLE
IL103-IL104	ILLUMINATION DETAILS
IL301-IL302	ILLUMINATION DETAILS
SS101	SIGNING AND STRIPING PLAN
SS102	SIGNING AND STRIPING DETAILS
SS103	SIGN AND POST DATA TABLE

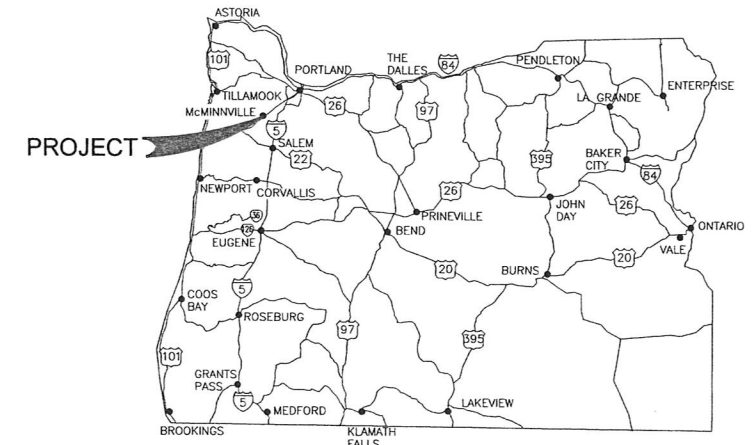

OREGON INDEX MAP  
NOT TO SCALE

## ADD ALTERNATIVE SHEETS ("CRAFT DISTRICT")

GN205	CRAFT DISTRICT CONTEXT
DT208	ROADWAY TYPICAL SECTIONS AND DETAILS
D202	DEMOLITION PLAN
C204-C206	ROADWAY PLAN
J204-J206	JOINTING PLAN
GR204-GR206	GRADING PLAN
SD203-SD204	STORM PLAN AND PROFILE
UT202	UTILITY PLAN
EC202	EROSION CONTROL PLAN
SU204-SU206	SURFACING PLAN
ST204-ST206	STREETSCAPE PLAN
IR202	IRRIGATION PLAN
PL204-PL206	PLANTING PLAN
IL205	LIGHTING PLAN
IL206	LIGHT POLE TABLE
IL207	ILLUMINATION DETAILS
SS204	SIGNING AND STRIPING PLAN
SS205	SIGNING AND STRIPING DETAILS
SS206	SIGN AND POST DATA TABLE

## ADD ALTERNATIVE 2 SHEETS

### (MCMINNVILLE WATER AND LIGHT)

W100	WATER CONSTRUCTION NOTES
W101-W104	WATER PLAN AND PROFILE SHEET
UE101-UE103	MWL ELECTRIC PLAN



PROJECT MANAGER STEPHANIE SERPICO, P.E.				
ISSUE	DATE	DESCRIPTION	PROJECT NUMBER	2016-8



CITY OF McMINNVILLE  
NE ALPINE AVENUE IMPROVEMENTS  
COVER SHEET AND INDEX





CONSTRUCTION NOTES

1. NO CONSTRUCTION SHALL BE STARTED WITHOUT A NOTICE TO PROCEED BY THE CITY ENGINEERING DEPARTMENT. THE CITY ENGINEERING DEPARTMENT AND THE DESIGN ENGINEER SHALL BE NOTIFIED AT LEAST TWO (2) WORKING DAYS PRIOR TO THE START OF CONSTRUCTION. ANY CONSTRUCTION WORK DONE PRIOR TO NOTICE TO PROCEED BEING ISSUED OR WITHOUT INSPECTION WILL BE REJECTED.

2. CONTRACTOR SHALL VERIFY ALL CONDITIONS ON THE JOB SITE INCLUDING BUT NOT LIMITED TO, ALL DIMENSIONS, GRADES, ELEVATIONS, EXTENT AND COMPATIBILITY TO EXISTING SITE CONDITIONS AND WITH THE WORK DESCRIBED ON THE ENGINEER'S DRAWINGS. ANY DISCREPANCIES OR UNEXPECTED CONDITIONS THAT AFFECT OR CHANGE THE WORK DESCRIBED IN THE CONTRACT DOCUMENTS SHALL BE BROUGHT TO THE ENGINEER'S ATTENTION IMMEDIATELY. CONTRACTOR SHALL NOT PROCEED WITH ANY OF THE WORK IN THE AREA OF DISCREPANCIES UNTIL ALL SUCH DISCREPANCIES ARE RESOLVED. IF THE CONTRACTOR CHOOSES TO DO SO, THEN IT IS UNDERSTOOD THAT THE CONTRACTOR IS CHOOSING TO PROCEED AT THE CONTRACTOR'S OWN RISK AND SHALL INCUR ALL COSTS, IF ANY, TO RESOLVE THE ISSUES TO THE SATISFACTION OF THE ENGINEER.

3. AN INSPECTOR ACTING ON BEHALF OF THE CITY MAY REQUIRE REVISIONS IN THE PLANS TO SOLVE UNFORESEEN PROBLEMS THAT MAY ARISE IN THE FIELD.

4. ALL CONSTRUCTION WORK AND INSTALLATIONS SHALL CONFORM TO THE CITY STANDARDS AND SPECIFICATIONS, OREGON STANDARD DRAWINGS AND SPECIFICATIONS FOR CONSTRUCTION, AND ALL WORK SHALL BE SUBJECT TO THE APPROVAL OF THE CITY.

5. IT SHALL BE THE RESPONSIBILITY OF THE CONTRACTOR TO CONTACT "UNDERGROUND LOCATE SERVICE" AT 1-800-332-2344 AT LEAST 48 BUSINESS-DAY HOURS PRIOR TO THE START OF CONSTRUCTION FOR THE LOCATION OF WATER, POWER, GAS, CABLE TV, AND TELEPHONE UNDERGROUND FACILITIES. THE CONTRACTOR WILL ALSO BE RESPONSIBLE FOR CONTACTING THE APPROPRIATE PUBLIC AGENCY FOR THE LOCATION OF UNDERGROUND FACILITIES.

6. ALL UTILITIES SHOWN ARE APPROXIMATE, ACCURATE TO THE EXTENT OF AVAILABLE RECORDS, AND FOR INFORMATIONAL PURPOSES ONLY. NO POT-HOLING TO VERIFY LOCATIONS OF EXISTING UNDERGROUND FACILITIES WAS AUTHORIZED BY THE OWNER. THE CONTRACTOR HAS THE RESPONSIBILITY TO VERIFY THE LOCATION OF EXISTING UNDERGROUND FACILITIES AND TO NOTIFY THE UTILITY COMPANIES WHEN WORKING IN THEIR PROXIMITY. CONTRACTOR TO VERIFY LOCATION OF EXISTING UTILITIES PRIOR TO CONSTRUCTION. OREGON LAW REQUIRES YOU TO FOLLOW RULES ADOPTED BY THE OREGON UTILITY NOTIFICATION CENTER. THOSE RULES ARE SET FORTH IN OAR 952-001-0010. YOU MAY OBTAIN COPIES OF THE RULES BY CALLING THE CENTER.

7. CONTRACTOR SHALL TAKE ALL NECESSARY PRECAUTIONS TO PROTECT EXISTING UTILITIES AND IMPROVEMENTS, UNLESS OTHERWISE NOTED ON THESE PLANS, INCLUDING COMPLYING WITH THE PROVISIONS OF ORS 757.557 (REQUIRES CONTRACTOR TO NOTIFY THE OREGON UTILITY NOTIFICATION CENTER AT LEAST 48 HOURS, BUT NO MORE THAN 10 BUSINESS DAYS PRIOR TO ANY EXCAVATION).

8. ANY DAMAGE TO EXISTING FACILITIES OR IMPROVEMENTS, RESULTING FROM THE CONTRACTOR'S OPERATION SHALL BE REPAIRED OR REPLACED AT THE CONTRACTOR'S EXPENSE.

9. CONTRACTOR SHALL EXPOSE, VERIFY, CONNECT AND/OR MATCH EXISTING UTILITIES AND IMPROVEMENTS IN CONFORMANCE WITH THE CITY OF MC MINNVILLE STANDARDS AND PROJECT SPECIFICATIONS, TO PROVIDE FOR COMPLETE AND/OR OPERATIONAL SYSTEMS.

10. WATER, POWER, CABLE, AND GAS UTILITY TRENCHING SHALL BE COMPLETED IN ACCORDANCE WITH PLANS AND SPECIFICATIONS FROM APPLICABLE UTILITY COMPANIES. THESE UTILITIES WILL BE INSTALLED BY THE APPLICABLE UTILITY COMPANY IN CONFORMANCE WITH THEIR JOINT TRENCH DETAIL. CONTRACTOR SHALL COORDINATE TRENCH EXCAVATIONS, BEDDING, AND BACKFILL WITH THESE UTILITY REPRESENTATIVES.

11. TRENCHES WITH PIPE COVER OF LESS THAN 12-INCHES TO SUBGRADE TO BE BACKFILLED WITH CLSM.

12. THE CONTRACTOR IS REQUIRED TO COORDINATE WITH UTILITIES DURING CONSTRUCTION. UTILITIES SHALL HAVE THE RIGHT TO ACCESS, INSTALL, MAINTAIN, AND OPERATE THEIR EQUIPMENT ABOVE AND BELOW GROUND WITHIN THE PUBLIC RIGHT-OF-WAY OR UTILITY EASEMENTS.

13. DURING THE COURSE OF THE WORK, CONTRACTOR SHALL COORDINATE AND ACCOMMODATE OTHER CONTRACTORS OR OPERATIONS OF OWNER.

14. CONTRACTOR SHALL RESTRICT ALL OPERATIONS TO PUBLIC RIGHT-OF-WAY AND WITHIN THE PROJECT BOUNDARIES AS SHOWN ON THESE PLANS. ANY DISRUPTION TO NATIVE LANDSCAPES OUTSIDE OF PUBLIC RIGHT-OF-WAY OR AS INDICATED BY THESE PLANS SHALL BE RESTORED AT NO COST TO THE OWNER.

15. ALL FINAL CUT SLOPES SHALL NOT EXCEED A GRADE OF 2 HORIZONTAL TO 1 VERTICAL UNLESS OTHERWISE APPROVED. FILL SLOPES SHALL NOT EXCEED A GRADE OF 2 HORIZONTAL TO 1 VERTICAL UNLESS OTHERWISE APPROVED BY THE ENGINEER OR SHOWN ON THESE PLANS.

16. THE CONTRACTOR SHALL EMPLOY ALL LABOR, EQUIPMENT, AND METHODS REQUIRED TO PREVENT DUST IN AMOUNTS DAMAGING TO PROPERTY, CULTIVATED VEGETATION, AND DOMESTIC ANIMALS OR CAUSING A NUISANCE TO PERSONS OCCUPYING BUILDINGS IN THE VICINITY OF THE JOB SITE. THE CONTRACTOR SHALL BE RESPONSIBLE FOR ANY DAMAGE CAUSED BY DUST RESULTING FROM CONSTRUCTION.

17. THE CONTRACTOR SHALL FOLLOW ALL APPLICABLE INDUSTRIAL SAFETY REGULATIONS. THE CITY OF MC MINNVILLE AND YAMHILL COUNTY AND THEIR OFFICIALS, THE ENGINEER, AND THE OWNER SHALL NOT BE RESPONSIBLE FOR ENFORCING SAFETY REGULATIONS.

18. MATERIAL QUANTITIES USED, NOTED, OR PROVIDED IN A SEPARATE ITEMIZED QUANTITY TAKE-OFF ARE AN ESTIMATE ONLY. FINAL MEASUREMENT AND PAYMENT WILL BE BASED ON FINAL MATERIALS AND QUANTITIES FURNISHED, MEASURED, AND ACCEPTED AS CALLED FOR IN THE BIDDING DOCUMENTS. SEE PROJECT SPECIFICATIONS FOR MEASUREMENT AND PAYMENT.

19. ALL WORK SHALL BE PERFORMED BY A CITY APPROVED CONTRACTOR.

20. ALL CONSTRUCTION SHALL CONFORM TO STATE AND FEDERAL STANDARDS REGARDING ACCESSIBILITY TO PEOPLE WITH DISABILITIES.

21. ALL GRADING SHALL BE IN CONFORMANCE WITH THESE PLANS AND SPECIFICATIONS AND CURRENT ADA REQUIREMENTS.

22. TEMPORARY ACCESS FOR ALL USERS, INCLUDING THOSE WITH DISABILITIES, SHALL BE MAINTAINED WITHIN THE EXISTING RIGHT-OF-WAY.

23. THE CONTRACTOR SHALL CONTROL TRAFFIC THROUGH THE PROJECT SITE IN CONFORMANCE WITH THE LATEST EDITION OF THE MANUAL ON UNIFORM TRAFFIC CONTROL DEVICES AND OREGON SUPPLEMENTS. THE CONTRACTOR SHALL AT ALL TIMES MAINTAIN LOCAL ACCESS FOR EMERGENCY VEHICLES, BUSINESSES, BUSES, AND HOMEOWNERS ALONG THE PROJECT SITE.

24. THE CONTRACTOR AND/OR SUB-CONTRACTOR SHALL HAVE A MINIMUM OF (1) SET OF APPROVED CONSTRUCTION PLANS ON THE JOB SITE AT ALL TIMES DURING THE CONSTRUCTION PHASES.

25. CONTRACTOR SHALL COORDINATE WITH AND SCHEDULE ALL EARTHWORK, TRENCH BACKFILL, ROAD CONSTRUCTION COMPACTION TESTS, AND GEOTECHNICAL REVIEW AS REQUIRED FOR ACCEPTANCE OF PROJECT WORK BY THE CITY OF MC MINNVILLE.

26. THE CONTRACTOR SHALL FOLLOW ALL RECOMMENDATIONS AS PROVIDED IN THE GEOTECHNICAL REPORT PREPARED BY HART CROWSER, DATED APRIL 12, 2016, INCLUDING SITE PREPARATION AND SUBGRADE STABILIZATION.

27. CONTRACTOR SHALL CAREFULLY MAINTAIN BENCHMARKS, PROPERTY CORNERS, MONUMENTS, AND OTHER REFERENCE POINTS PURSUANT TO ORS 209.140 AND ORS 209.150. IF SUCH POINTS ARE DISTURBED OR DESTROYED BY CONSTRUCTION ACTIVITIES THE CONTRACTOR SHALL NOTIFY THE ENGINEER AND PAY FOR THEIR REPLACEMENT BY EMPLOYING A PROFESSIONAL LAND SURVEYOR TO RESET PROPERTY CORNERS & OTHER SUCH MONUMENTS.

28. AT THE PRECONSTRUCTION MEETING, PRIOR TO BEGINNING WORK, THE CONTRACTOR SHALL PRESENT A LIST OF SUBCONTRACTORS, A PROJECT SCHEDULE, A TRAFFIC CONTROL PLAN, AND A LIST OF AT LEAST THREE PEOPLE, WITH PHONE NUMBERS RESPONSIBLE FOR MAINTAINING TRAFFIC CONTROL DURING NON-WORK PERIOD.


29. FINAL CLEANUP - PRIOR TO FINAL ACCEPTANCE AND PAYMENT, THE CONTRACTOR SHALL CLEAN THE WORK SITE AND ADJACENT AREAS OF ANY DEBRIS, DISCARDED ASPHALTIC CONCRETE MATERIAL OR OTHER ITEMS DEPOSITED BY THE CONTRACTOR'S PERSONNEL DURING THE PERFORMANCE OF THIS CONTRACT.




ISSUE	DATE	DESCRIPTION

PROJECT MANAGER STEPHANIE SERPICO, P.E.

PROJECT NUMBER	2016-8

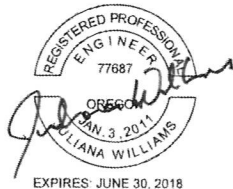

CITY OF MC MINNVILLE  
NE ALPINE AVENUE IMPROVEMENTS  
GENERAL CONSTRUCTION NOTES

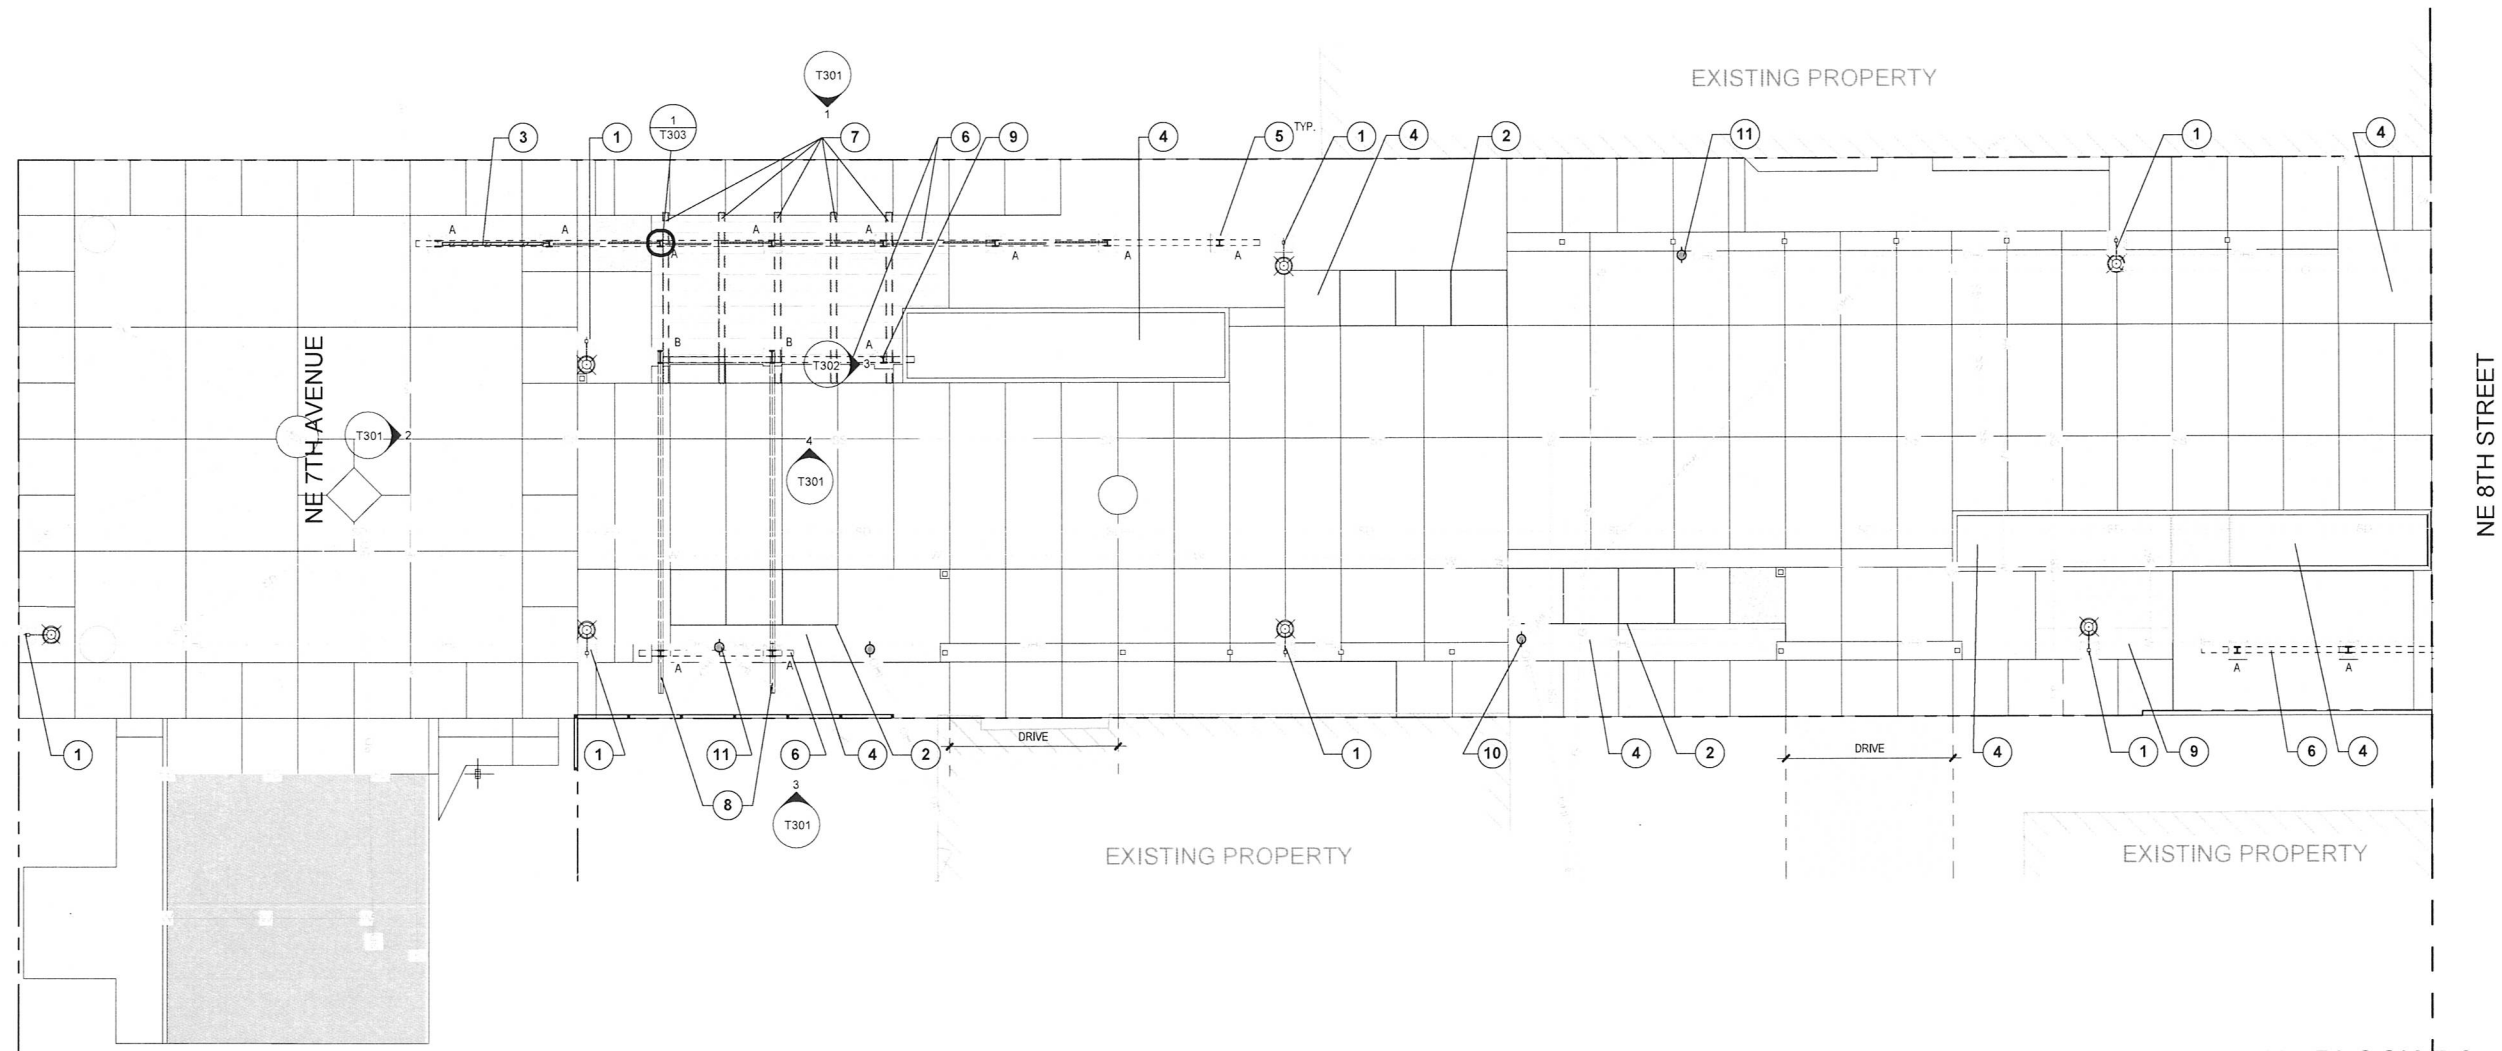

STEEL STRUCTURE PLAN - BLOCK 7-8 1  
1" = 10'-0"

LEGEND - STEEL STRUCTURE


- A I WEATHERING STEEL COLUMN, SEE STRUCTURAL  
B I WEATHERING STEEL GATEWAY COLUMN, SEE STRUCTURAL  
CONC BUMPER FOR COLUMN, SEE STRUCTURAL

CONSTRUCTION NOTES - STEEL STRUCTURE

- 1 STREET LIGHT, SEE ILLUMINATION PLANS  
2 STEEL PLANTER WALL EDGE, SEE 4.5/ST 301  
3 ALPINE GATEWAY SIGN, SEE 1/T202 OR 2/T202 AND STRUCTURAL  
4 PLANTING AREA, SEE PLANTING PLANS  
5 CONCRETE BUMPER, SEE STRUCTURAL DETAILS  
6 HSS STEEL BEAM, SEE STRUCTURAL DETAILS  
7 RECLAIMED WOOD TIMBER JOIST, SEE STRUCTURAL DETAILS  
8 STEEL GATEWAY BEAM, SEE STRUCTURAL DETAILS  
9 ELECTRICAL CONDUIT AND OUTLET ON STEEL STRUCTURE, SEE 3/T202 AND ELECTRICAL DRAWINGS  
10 EXISTING POWER POLE  
11 EXISTING POWER POLE TO BE REMOVED BY UTILITY

KEY MAP

N.T.S.

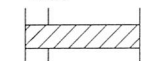

THIS SHEET



PROJECT MANAGER		
ISSUE	DATE	DESCRIPTION

PROJECT NUMBER	

FOR REFERENCE ONLY  
SEE STRUCTURAL  
DRAWINGS FOR  
CONSTRUCTION

CITY OF MCMINNVILLE  
NE ALPINE AVENUE IMPROVEMENTS  
STEEL STRUCTURE PLAN




SCALE  
1" = 10'  
DATE 09/2016

0 10 20 FEET

SHEET T101



1 2 3 4 5 6 7 8

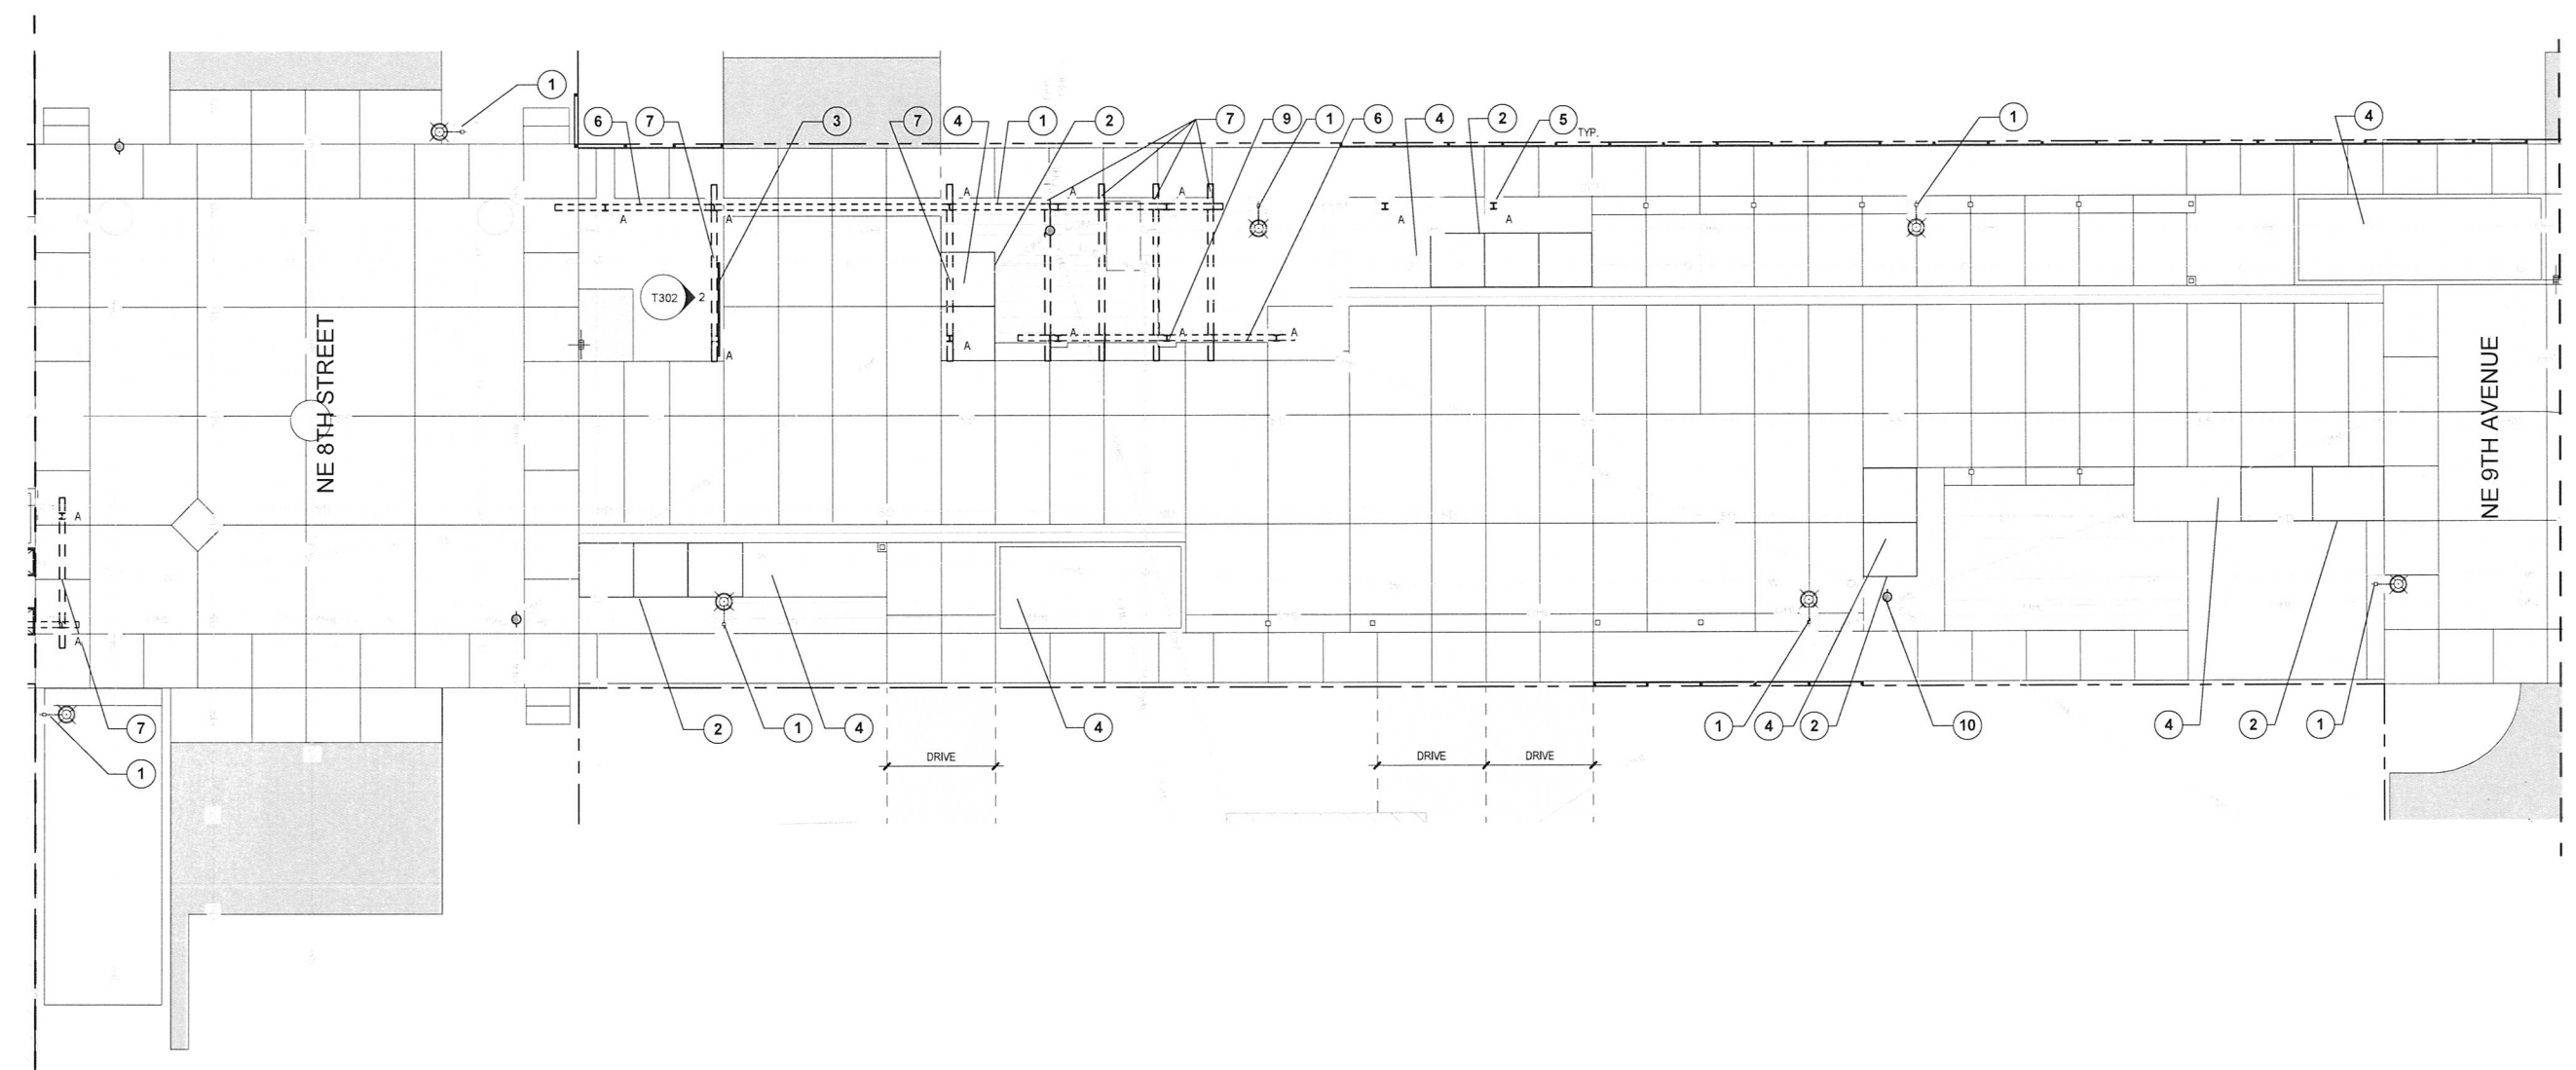

STEEL STRUCTURE PLAN - BLOCK 8-9 1  
1" = 10'-0"


LEGEND - STEEL STRUCTURE

- A WEATHERING STEEL COLUMN, SEE STRUCTURAL
- B WEATHERING STEEL GATEWAY COLUMN, SEE STRUCTURAL
- CONC BUMPER FOR COLUMN, SEE STRUCTURAL

CONSTRUCTION NOTES - STEEL STRUCTURE

- 1 STREET LIGHT, SEE ILLUMINATION PLANS
- 2 STEEL PLANTER WALL EDGE, SEE 4,5/ST 301
- 3 ALPINE GATEWAY SIGN, SEE 1/T202 OR 2/T202 AND STRUCTURAL
- 4 PLANTING AREA, SEE PLANTING PLANS
- 5 CONCRETE BUMPER, SEE STRUCTURAL DETAILS
- 6 HSS STEEL BEAM, SEE STRUCTURAL DETAILS
- 7 RECLAIMED WOOD TIMBER JOIST, SEE STRUCTURAL DETAILS
- 8 STEEL GATEWAY BEAM, SEE STRUCTURAL DETAILS
- 9 ELECTRICAL CONDUIT AND OUTLET ON STEEL STRUCTURE, SEE 3/T202 AND ELECTRICAL DRAWINGS
- 10 EXISTING POWER POLE
- 11 EXISTING POWER POLE TO BE REMOVED BY UTILITY

KEY MAP

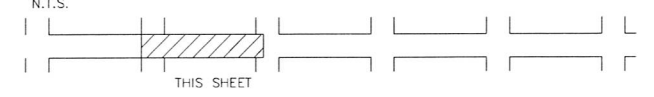

ISSUE	DATE	DESCRIPTION

PROJECT MANAGER	
PROJECT NUMBER	

FOR REFERENCE ONLY  
SEE STRUCTURAL  
DRAWINGS FOR  
CONSTRUCTION


CITY OF MCMINNVILLE  
NE ALPINE AVENUE IMPROVEMENTS  
STEEL STRUCTURE PLAN



SCALE  
DATE 09/2016

0 10 20 FEET  
1" = 10'

SHEET T102

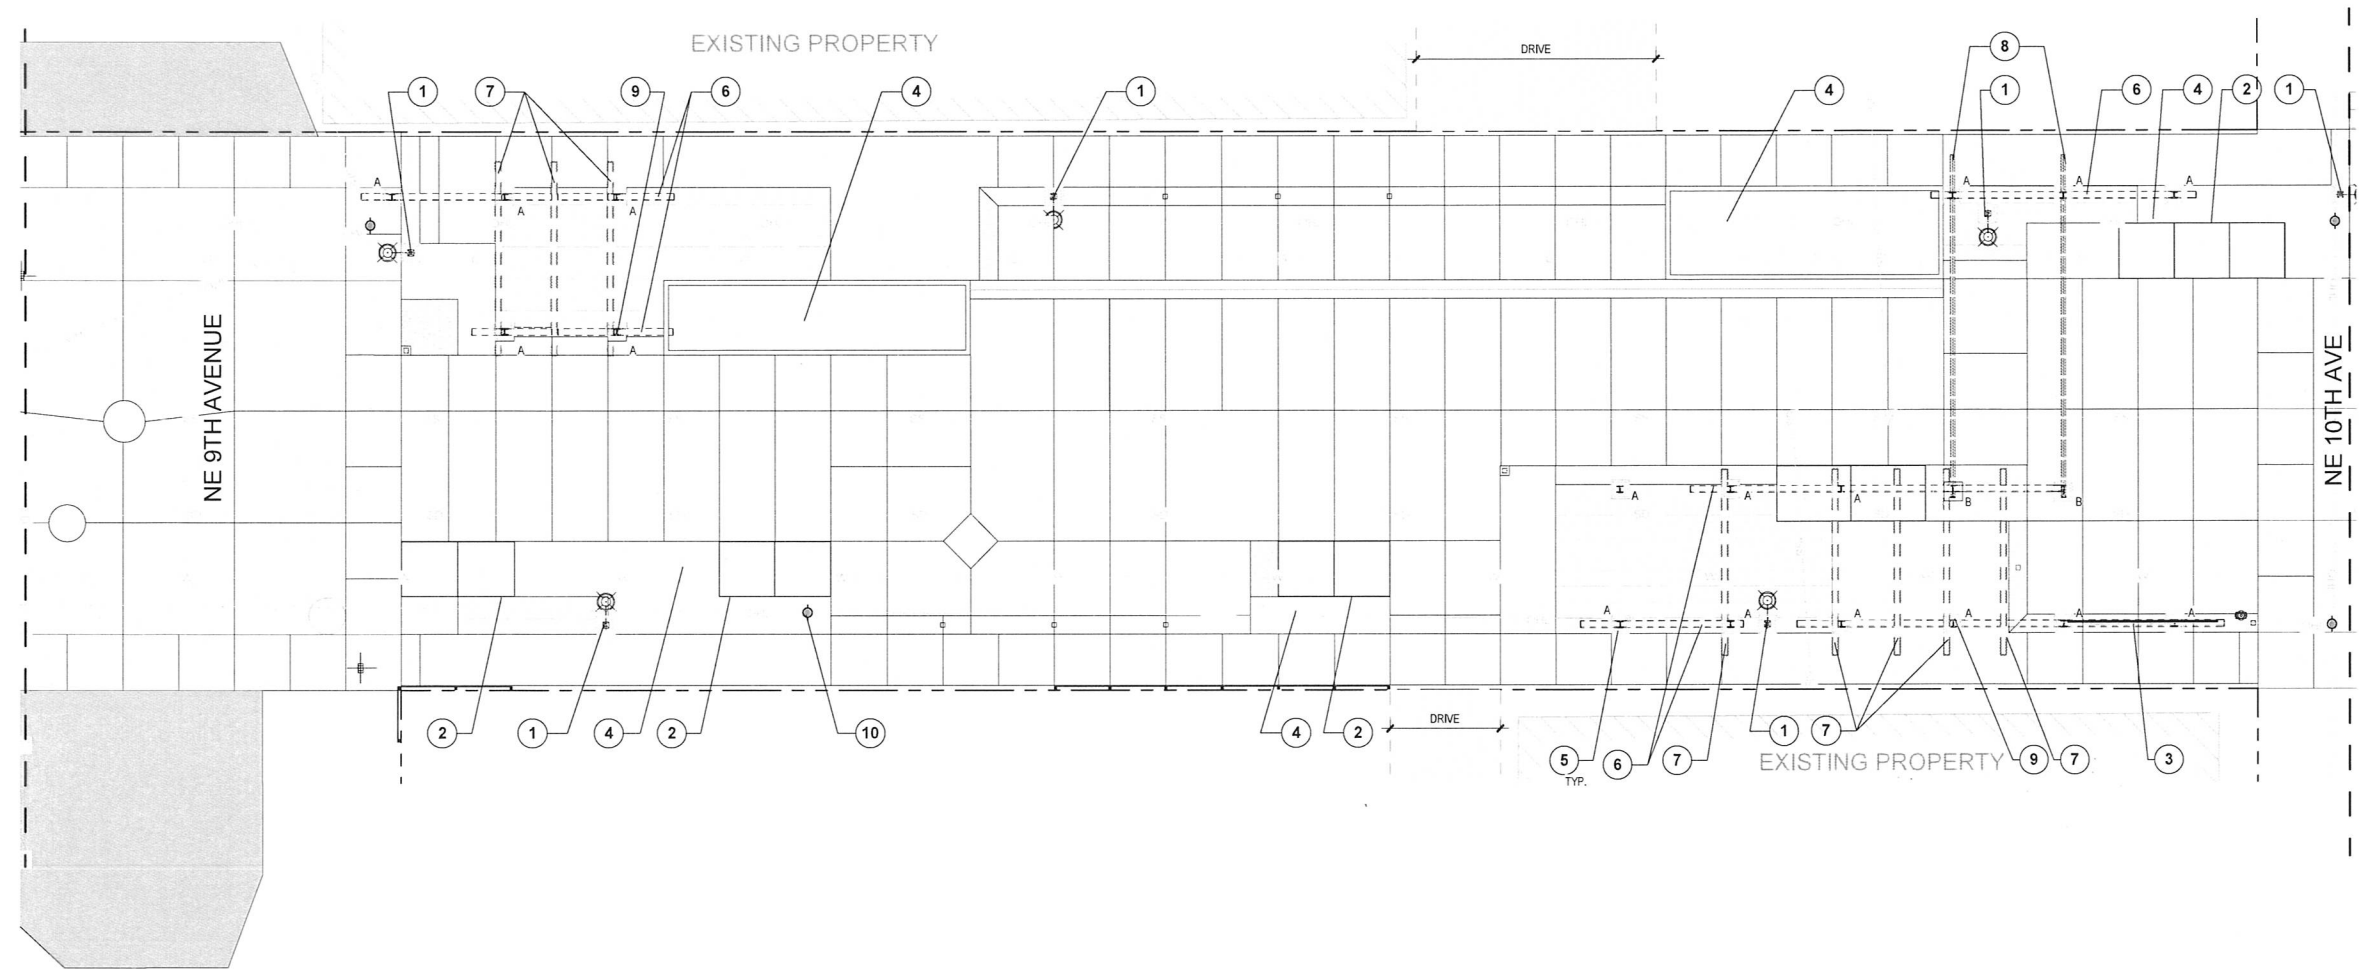

STEEL STRUCTURE PLAN - BLOCK 9-10 1  
1" = 10'-0"


LEGEND - STEEL STRUCTURE

A	I	WEATHERING STEEL COLUMN, SEE STRUCTURAL
B	I	WEATHERING STEEL GATEWAY COLUMN, SEE STRUCTURAL
		CONC BUMPER FOR COLUMN, SEE STRUCTURAL

CONSTRUCTION NOTES - STEEL STRUCTURE

1	STREET LIGHT, SEE ILLUMINATION PLANS
2	STEEL PLANTER WALL EDGE, SEE 4.5/ST 301
3	ALPINE GATEWAY SIGN, SEE 1/T202 OR 2/T202 AND STRUCTURAL
4	PLANTING AREA, SEE PLANTING PLANS
5	CONCRETE BUMPER, SEE STRUCTURAL DETAILS
6	HSS STEEL BEAM, SEE STRUCTURAL DETAILS
7	RECLAIMED WOOD TIMBER JOIST, SEE STRUCTURAL DETAILS
8	STEEL GATEWAY BEAM, SEE STRUCTURAL DETAILS
9	ELECTRICAL CONDUIT AND OUTLET ON STEEL STRUCTURE, SEE 3/T202 AND ELECTRICAL DRAWINGS
10	EXISTING POWER POLE
11	EXISTING POWER POLE TO BE REMOVED BY UTILITY

KEY MAP  
N.T.S.

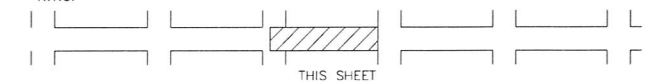

PROJECT MANAGER				
ISSUE	DATE	DESCRIPTION	PROJECT NUMBER	


FOR REFERENCE ONLY  
SEE STRUCTURAL  
DRAWINGS FOR  
CONSTRUCTION

CITY OF MCMINNVILLE  
NE ALPINE AVENUE IMPROVEMENTS  
STEEL STRUCTURE PLAN



SCALE 1" = 10'  
DATE 09/2016  
SHEET T103



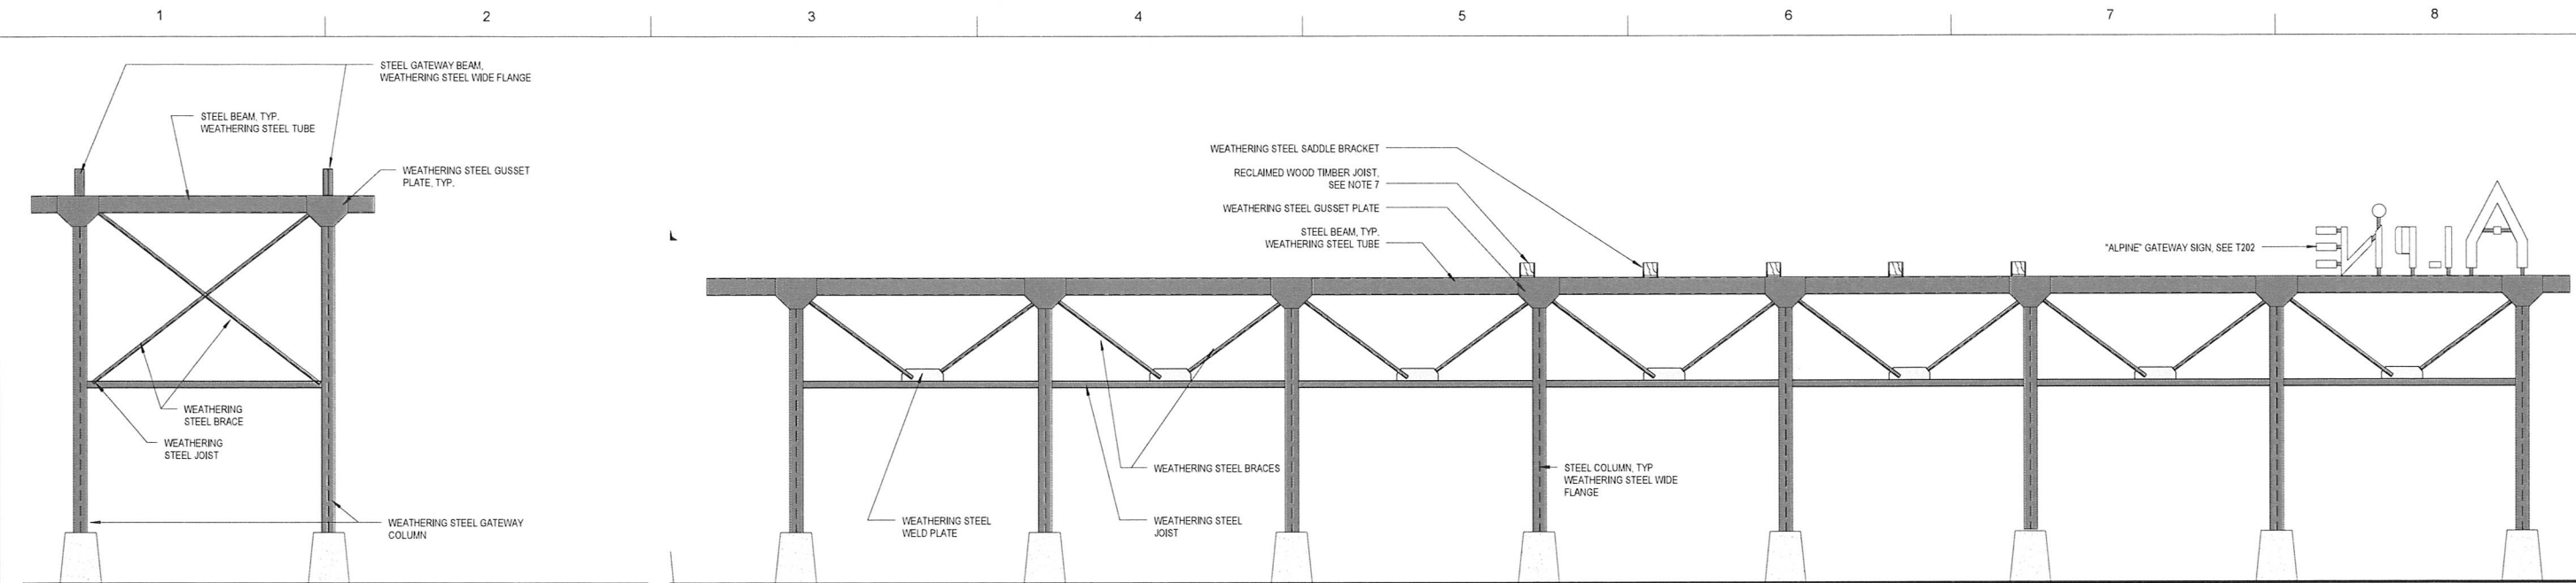

**SOUTH ELEVATION**


1/4" = 1'-0"

3

**NORTH ELEVATION**

1/4" = 1'-0"


1

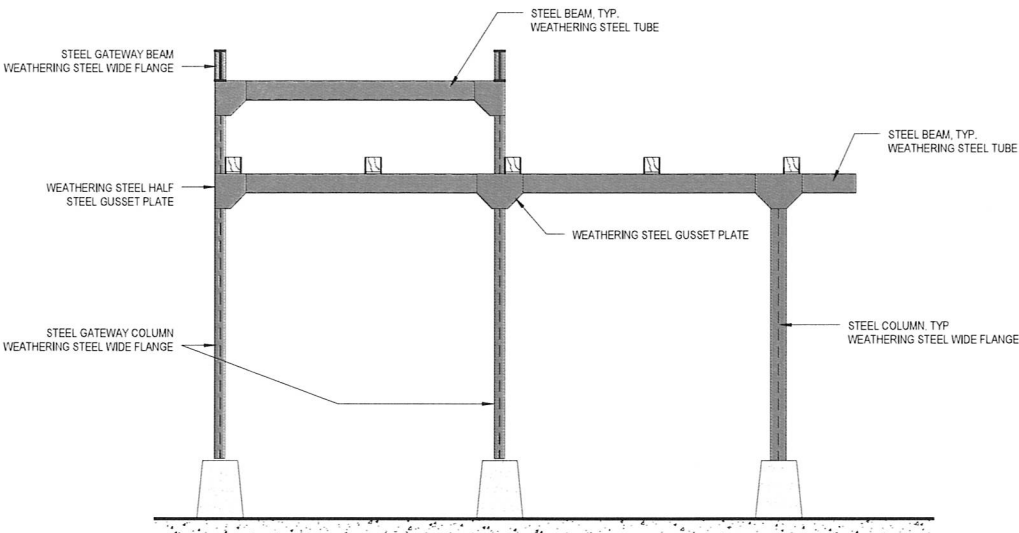

**INSIDE SOUTH ELEVATION**

1/4" = 1'-0"

4

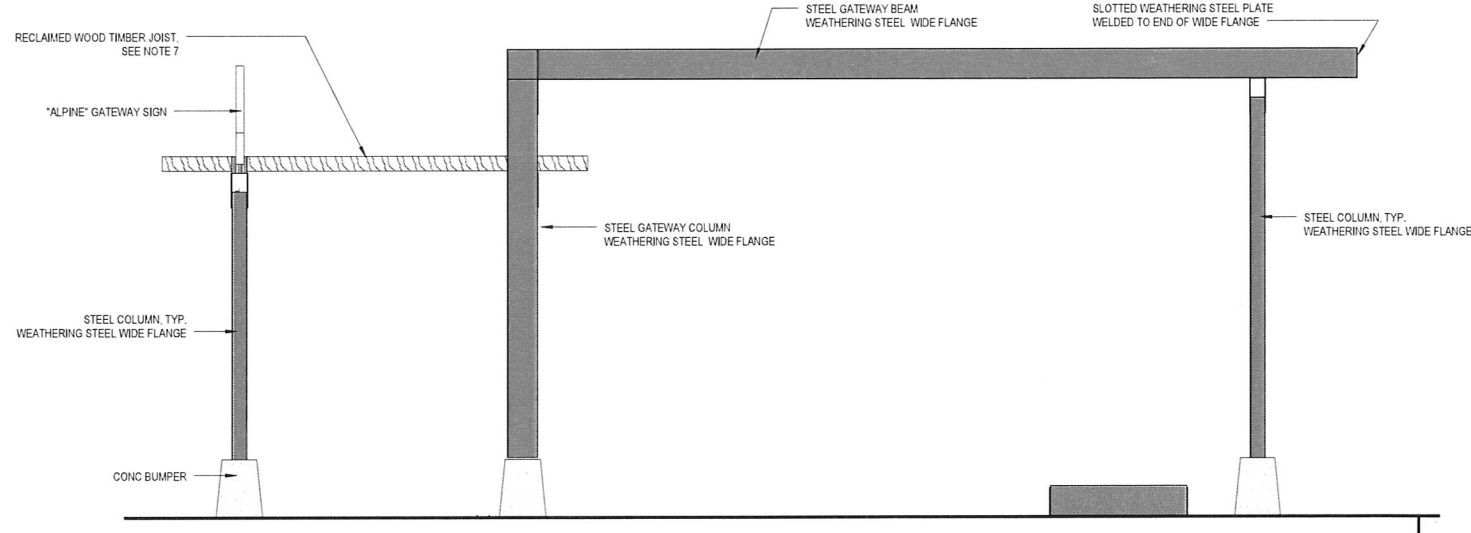

**7TH GATEWAY ELEVATION**

1/4" = 1'-0"

2

**GENERAL NOTES**

- ALL SCREW LOCATIONS ARE TO BE PREDRILLED SO AS TO PREVENT SPLITTING. THERE IS TO BE NO WOOD SPLITTING ANYWHERE ON THE FINISHED PRODUCT.
- WOOD + STEEL ARE TO RECEIVE ANTI-GRAFFITI COATING.
- ALL YELLOW POWDERCOATED STEEL SHOULD BE: T009-YL14 90% GLOSS YELLOW #13538.
- THERE ARE TO BE NO SHARP CORNERS OR EDGES ON ANY EXPOSED STEEL. ALL STEEL EDGES ARE TO BE DEBURRED. ALL EXPOSED STEEL EDGES ARE TO HAVE A ROUNDOVER OF 1/16" MIN. ALL STEEL CORNER ARE TO HAVE A 1/4" RADIUS UNLESS OTHERWISE NOTED.
- SEE STRUCTURAL DRAWINGS FOR SIZES AND CONSTRUCTION.
- SEE ELECTRICAL DRAWINGS FOR WIRING.
- CONTRACTOR IS TO CONTACT DESIGNER OR SEND PICTURES OF RECLAIMED WOOD PRIOR TO DOING ANY CUTTING, SAWING, PLANING, ETC. DESIGNER WILL DETERMINE ORIGINAL PATINA ON RECLAIMED TIMBER IS ACCEPTABLE OR IF TIMBER NEEDS TO BE RESAWN.



ISSUE	DATE	DESCRIPTION

PROJECT MANAGER	
PROJECT NUMBER	

**FOR REFERENCE ONLY  
SEE STRUCTURAL  
DRAWINGS FOR  
CONSTRUCTION**

**CITY OF MCMINNVILLE  
NE ALPINE AVENUE IMPROVEMENTS  
STEEL STRUCTURE DETAILS**



SCALE AS INDICATED  
DATE 09/2016

SHEET **T301**

1

2

3


4

5


6

7


8

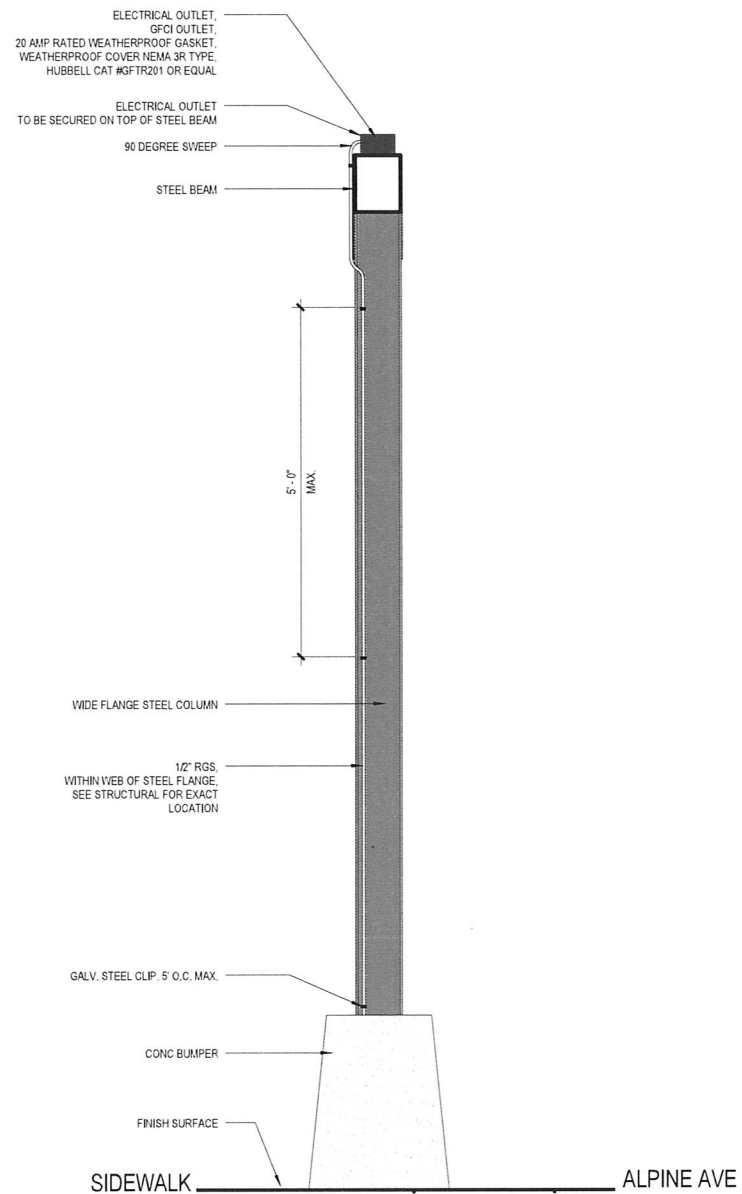

ELECTRICAL CONDUIT ELEVATION 3  
3/4" = 1'-0"

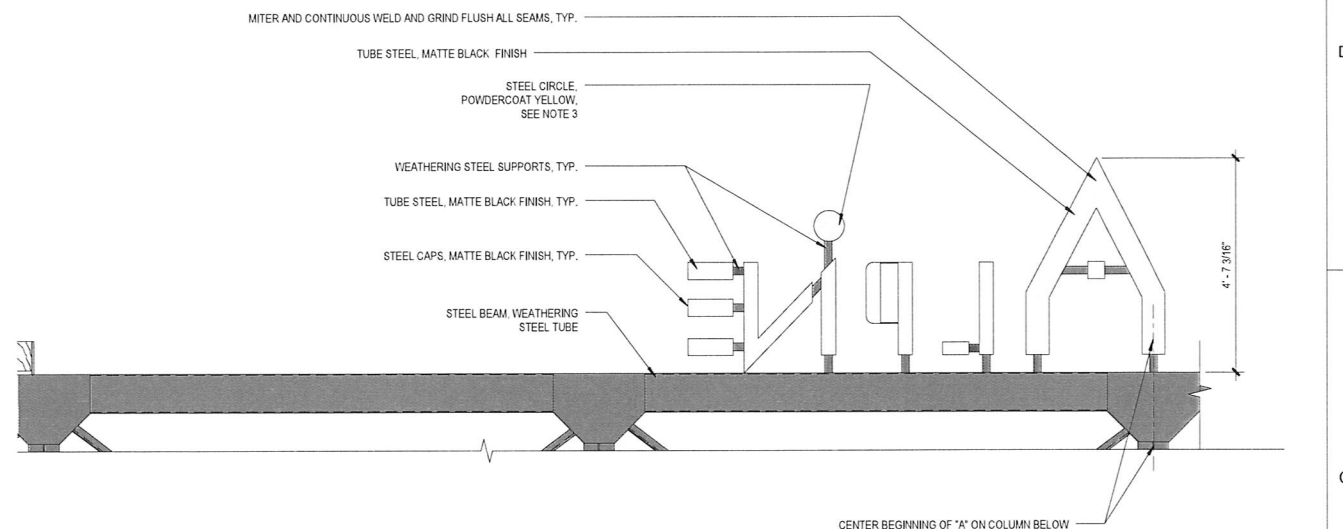

GATEWAY SIGN ON STEEL BEAM 1  
1/2" = 1'-0"

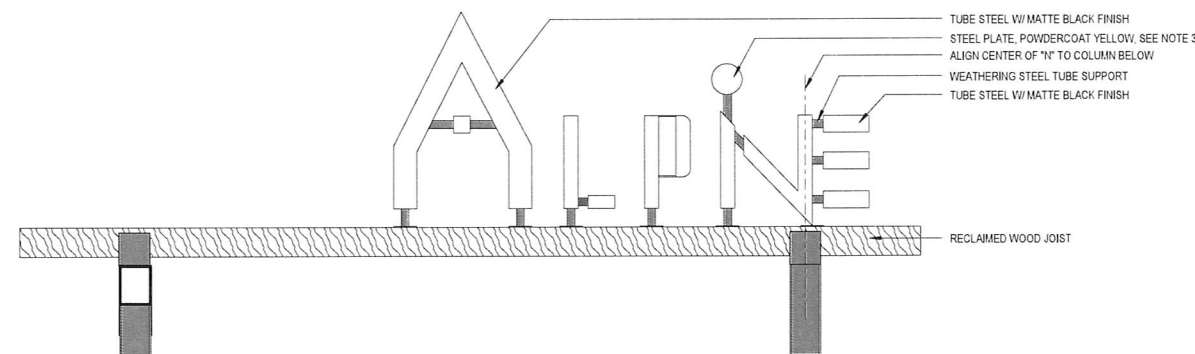

GATEWAY SIGN ON WOOD JOIST 2  
1/2" = 1'-0"

#### GENERAL NOTES

- ALL SCREW LOCATIONS ARE TO BE PREDRILLED SO AS TO PREVENT SPLITTING. THERE IS TO BE NO WOOD SPLITTING ANYWHERE ON THE FINISHED PRODUCT
- WOOD + STEEL ARE TO RECEIVE ANTI-GRAFFITI COATING
- ALL YELLOW POWDERCOATED STEEL SHOULD BE: T009-YL14 90% GLOSS YELLOW #13538
- THERE ARE TO BE NO SHARP CORNERS OR EDGES ON ANY EXPOSED STEEL. ALL STEEL EDGES ARE TO BE DEBURRED. ALL EXPOSED STEEL EDGES ARE TO HAVE A ROUNDOVER OF 1/16" MIN. ALL STEEL CORNER ARE TO HAVE A 1/4" RADIUS UNLESS OTHERWISE NOTED.
- SEE STRUCTURAL DRAWINGS FOR SIZES AND CONSTRUCTION
- SEE ELECTRICAL DRAWINGS FOR WIRING
- CONTRACTOR IS TO CONTACT DESIGNER OR SEND PICTURES OF RECLAIMED WOOD PRIOR TO DOING ANY CUTTING, SAWING, PLANING, ETC. DESIGNER WILL DETERMINE ORIGINAL PATINA ON RECLAIMED TIMBER IS ACCEPTABLE OR IF TIMBER NEEDS TO BE RESAWN.



PROJECT MANAGER		
ISSUE	DATE	DESCRIPTION

PROJECT NUMBER	

FOR REFERENCE ONLY  
SEE STRUCTURAL  
DRAWINGS FOR  
CONSTRUCTION


CITY OF MCMINNVILLE  
NE ALPINE AVENUE IMPROVEMENTS  
STEEL STRUCTURE DETAILS



SCALE AS INDICATED  
DATE 09/2016

SHEET T302



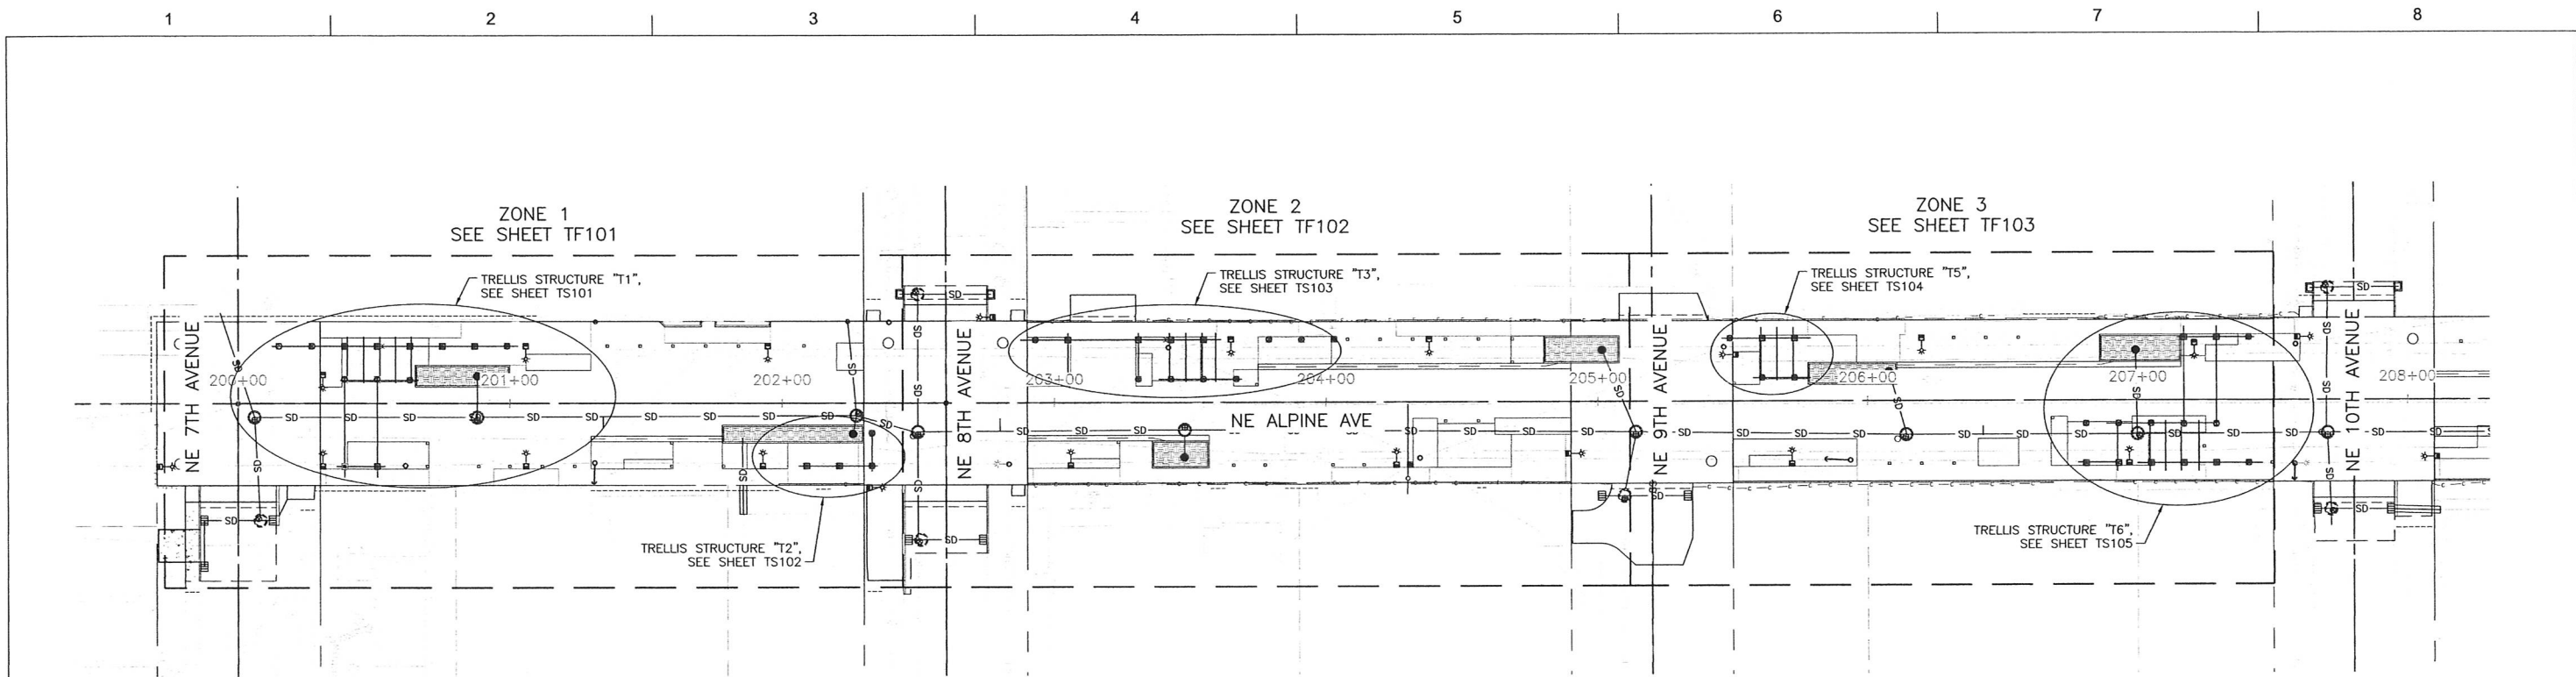

**GENERAL NOTES:**

- ALL MATERIALS AND WORKMANSHIP SHALL BE IN ACCORDANCE WITH THESE PLANS, THE TECHNICAL SPECIFICATIONS, AND THE REQUIREMENTS OF THE OREGON DEPARTMENT OF TRANSPORTATION STANDARD SPECIFICATIONS, 2015.
- ALL COLUMNS SHALL BE SET AND INSTALLED PLUMB.
- PRIOR TO FIELD WORK, CONTRACTOR SHALL:
  - FIELD VERIFY ALL MEASUREMENTS AND ALERT THE ENGINEER OF ANY DISCREPANCIES.
  - FIELD VERIFY FOUNDATION ELEVATIONS AND LOCATIONS PRIOR TO DELIVERING STRUCTURAL STEEL TO THE JOB SITE.
  - VERIFY ANY POTENTIAL GROUND CONFLICTS.
  - SUBMIT SHOP DRAWINGS TO THE ENGINEER FOR REVIEW AND CONFORMANCE WITH THE GENERAL INTENT OF THE DESIGN PLANS.

**APPLICABLE DESIGN CRITERIA:**

TRELLIS STRUCTURE DESIGNED IN ACCORDANCE WITH:

- AASHTO STANDARD SPECIFICATIONS FOR STRUCTURAL SUPPORTS FOR HIGHWAY SIGNS, LUMINAIRES, AND TRAFFIC SIGNALS, SIXTH EDITION, 2013.
  - WIND LOADING:
    - THREE-SECOND, BASIC WIND SPEED,  $V = 95$  MPH (REF. ODOT TM671).
    - $I_r$ , IMPORTANCE VALUE, 1.00.
    - RECURRENCE INTERVAL, 50 YEARS.
    - $C_v = 1.00$ ,  $G = 1.14$ ,  $C_d = 1.7$ .
    - $P_z = 41$  PSF APPLIED TO ALL EXPOSED AND HORIZONTALLY PROJECTED FACES.
  - VEHICULAR IMPACT:
    - AN EQUIVALENT STATIC 18.0 KIP HORIZONTAL LOADING APPLIED AT 2'-3" ABOVE FINISHED GRADE EQUIVALENT TO:
      - 6,500 LB PICKUP IMPACTING AT 4.5 MPH.
      - 66,000 LB TRUCK IMPACTING AT 1.5 MPH.

**MATERIALS:**

- ALL STRUCTURAL STEEL HAS BEEN DESIGNED IN ACCORDANCE WITH AISC SPECIFICATIONS FOR STEEL BUILDINGS, SHALL BE CORROSION RESISTANT, HIGH STRENGTH, LOW ALLOY (WEATHERING STEEL), AND MEETING SPECIFICATION 00560 AND THE FOLLOWING:
  - PLATES SHALL MEET A242 GRADE 50.
  - HOLLOW STRUCTURAL SECTIONS SHALL MEET ASTM A847 GRADE 50.
  - WIDE FLANGE STRUCTURAL SECTIONS AND ANGLES SHALL MEET ASTM A588 GRADE 50.
  - ANCHOR RODS SHALL BE IN ACCORDANCE WITH SPECIFICATION 02560.40, AND BE FULLY THREADED RODS MEETING ASTM A449-3, GRADE 120, WITH ASTM A563 DH NUTS AND ASTM F436 WASHERS, TYPE 3, IN ACCORDANCE WITH SPECIFICATION 02560.30.
  - STRUCTURAL STEEL BOLTS SHALL BE ASTM F3125 A325, TYPE 3, INSTALLED SNUG-TIGHT UNLESS NOTED OTHERWISE AND IN ACCORDANCE WITH SPECIFICATION 02560.20. FURNISH LOCK NUTS OR PAIRED NUTS AND LOCK WASHERS WITH ALL THREADED FASTENERS. WASHERS TO BE ASTM F326 TYPE 3. NUTS TO BE ASTM A563 DH3.
  - WELDING SHALL BE IN ACCORDANCE WITH SPECIFICATION 00560.26(b) AND SHALL MEET THE REQUIREMENTS OF AWS D1.1. SUBMIT WELDING SEQUENCES AND PROCEDURE TO THE ENGINEER FOR APPROVAL PRIOR TO COMMENCING ALL WORK UNLESS NOTED OTHERWISE. USE A MINIMUM:
    - $\frac{3}{8}$ " FILLET WELDS EXCEPT AS SHOWN.
    - COMPLETE JOINT PENETRATION WELDS FOR SPICED MEMBERS TO DEVELOP 100% NORMAL FLEXURE AND SHEAR CAPACITY OF THE SECTION AND TO PRODUCE A CONTINUOUS MEMBER.
    - WELDING AND CONSUMABLES SHALL MEET AWS 1.1 WITH 70 KSI (EXX70).
  - STEEL BEAMS SHALL BE STRAIGHT AND PRODUCED WITHOUT CAMBER.
- REINFORCED CONCRETE FOR PEDESTALS SHALL BE IN ACCORDANCE WITH SPECIFICATION 00540. IN ADDITION:
  - SHALL MEET CLASS 4000 HAVING A MINIMUM 28-DAY COMPRESSION STRENGTH OF 4,000 PSI.
  - ALL EXPOSED EDGES SHALL BE CHAMFERED  $\frac{1}{2}$ " UNLESS NOTED OTHERWISE.
  - PEDESTAL FINISHES AND COLOR SHALL MEET THE SPECIFICATIONS AND ARCHITECTURAL REQUIREMENTS.

3. FOUNDATIONS SHALL MEET THE REQUIREMENTS OF TF301.

**MATERIALS:**

- REINFORCING STEEL SHALL MEET ASTM A615, GRADE 60.
- MINIMUM COVER SHALL BE:
  - 1.5" FOR ABOVE GROUND CONDITIONS.
  - 3.0" FOR BELOW GROUND CONDITIONS.
- RECLAIMED OR SALVAGED HEAVY TIMBER SHALL MEET SPECIFICATION 00570 AND:
  - DOUGLAS FIR, MEETING NDS, GRADE 1 OR BETTER.
- PRESERVATIVE TREATMENT FOR EXTERIOR EXPOSURE WITH AWPA STANDARD. USE CATEGORY UC3B.
- APPLY AN ANTI-GRAFFITI COATING TO THE TRELLIS STRUCTURE IN ACCORDANCE WITH THE TECHNICAL SPECIFICATION 01096.

**ABBREVIATIONS:**

ELEV.	ELEVATION
OPP.	OPPOSITE HAND
SIM.	SIMILAR
T.O.S.	TOP OF STRUCTURE
TYP.	TYPICAL
W.P.	WORK POINT
C.	CENTER LINE
P.	PLATE
CLR.	CLEARANCE
MIN.	MINIMUM

**REFERENCES:**

- FOR PROJECT SHEET INDEX, SEE SHEET GN100.
- FOR GENERAL LEGEND AND ABBREVIATIONS, SEE SHEET GN101.
- FOR GENERAL CONSTRUCTION NOTES, SEE SHEET GN102.
- FOR TYPICAL NE ALPINE AVE CROSS SECTION AND PAVEMENT DETAILS, SEE "DT" SHEETS.
- FOR TRAFFIC CONTROL PLAN, SEE "TC" SHEETS.
- FOR EXISTING CONDITIONS, SURVEY, AND DEMOLITION PLANS, SEE "S" AND "D" SHEETS.
- FOR CIVIL WORKS, SEE "C" SHEETS.
- FOR PAVEMENT JOINTING DETAILS, SEE "J" SHEETS.
- SEE "GR" SHEETS FOR GRADING PLANS AND STATION, OFFSET, AND ELEVATION INFORMATION FOR ALL CURBS, GRADING, AND CRITICAL POINTS NOT SHOWN ON THIS PLAN.
- FOR STORM DRAINAGE AND UTILITY PLANS, SEE "SD" AND "U" SHEETS.
- FOR EROSION CONTROL PLANS, SEE "EC" SHEETS.
- FOR SURFACING AND STREETSCAPE PLANS, SEE "SU" AND "ST" SHEETS.
- FOR PLANTING AND IRRIGATION PLANS, SEE "PL" AND "IR" SHEETS.
- FOR ILLUMINATION DETAILS, SEE "IL" SHEETS.
- FOR SIGNING AND STRIPING DETAILS, SEE "SS" SHEETS.
- FOR ARCHITECTURAL DETAILS, SEE "T" SHEETS.

**TRELLIS STRUCTURE LEGEND:**

HSS	FRAMING MEMBER
T8x8	HEAVY TIMBER FRAMING MEMBER
X	SPLICE LOCATION (IF REQUIRED TO MEET FRAMING LENGTHS)



ISSUE	DATE	DESCRIPTION
1	1-16-17	REVISED NOTES

PROJECT MANAGER STEPHANIE SERPICO, P.E.

PROJECT NUMBER	2016-8
----------------	--------




CITY OF MCMINNVILLE  
NE ALPINE AVENUE IMPROVEMENTS  
TRELLIS STRUCTURE KEY PLAN & NOTES  
NE ALPINE AVENUE STA: 202+44 TO 207+50




HORIZONTAL SCALE




DATE 12/2016 SHEET TS100

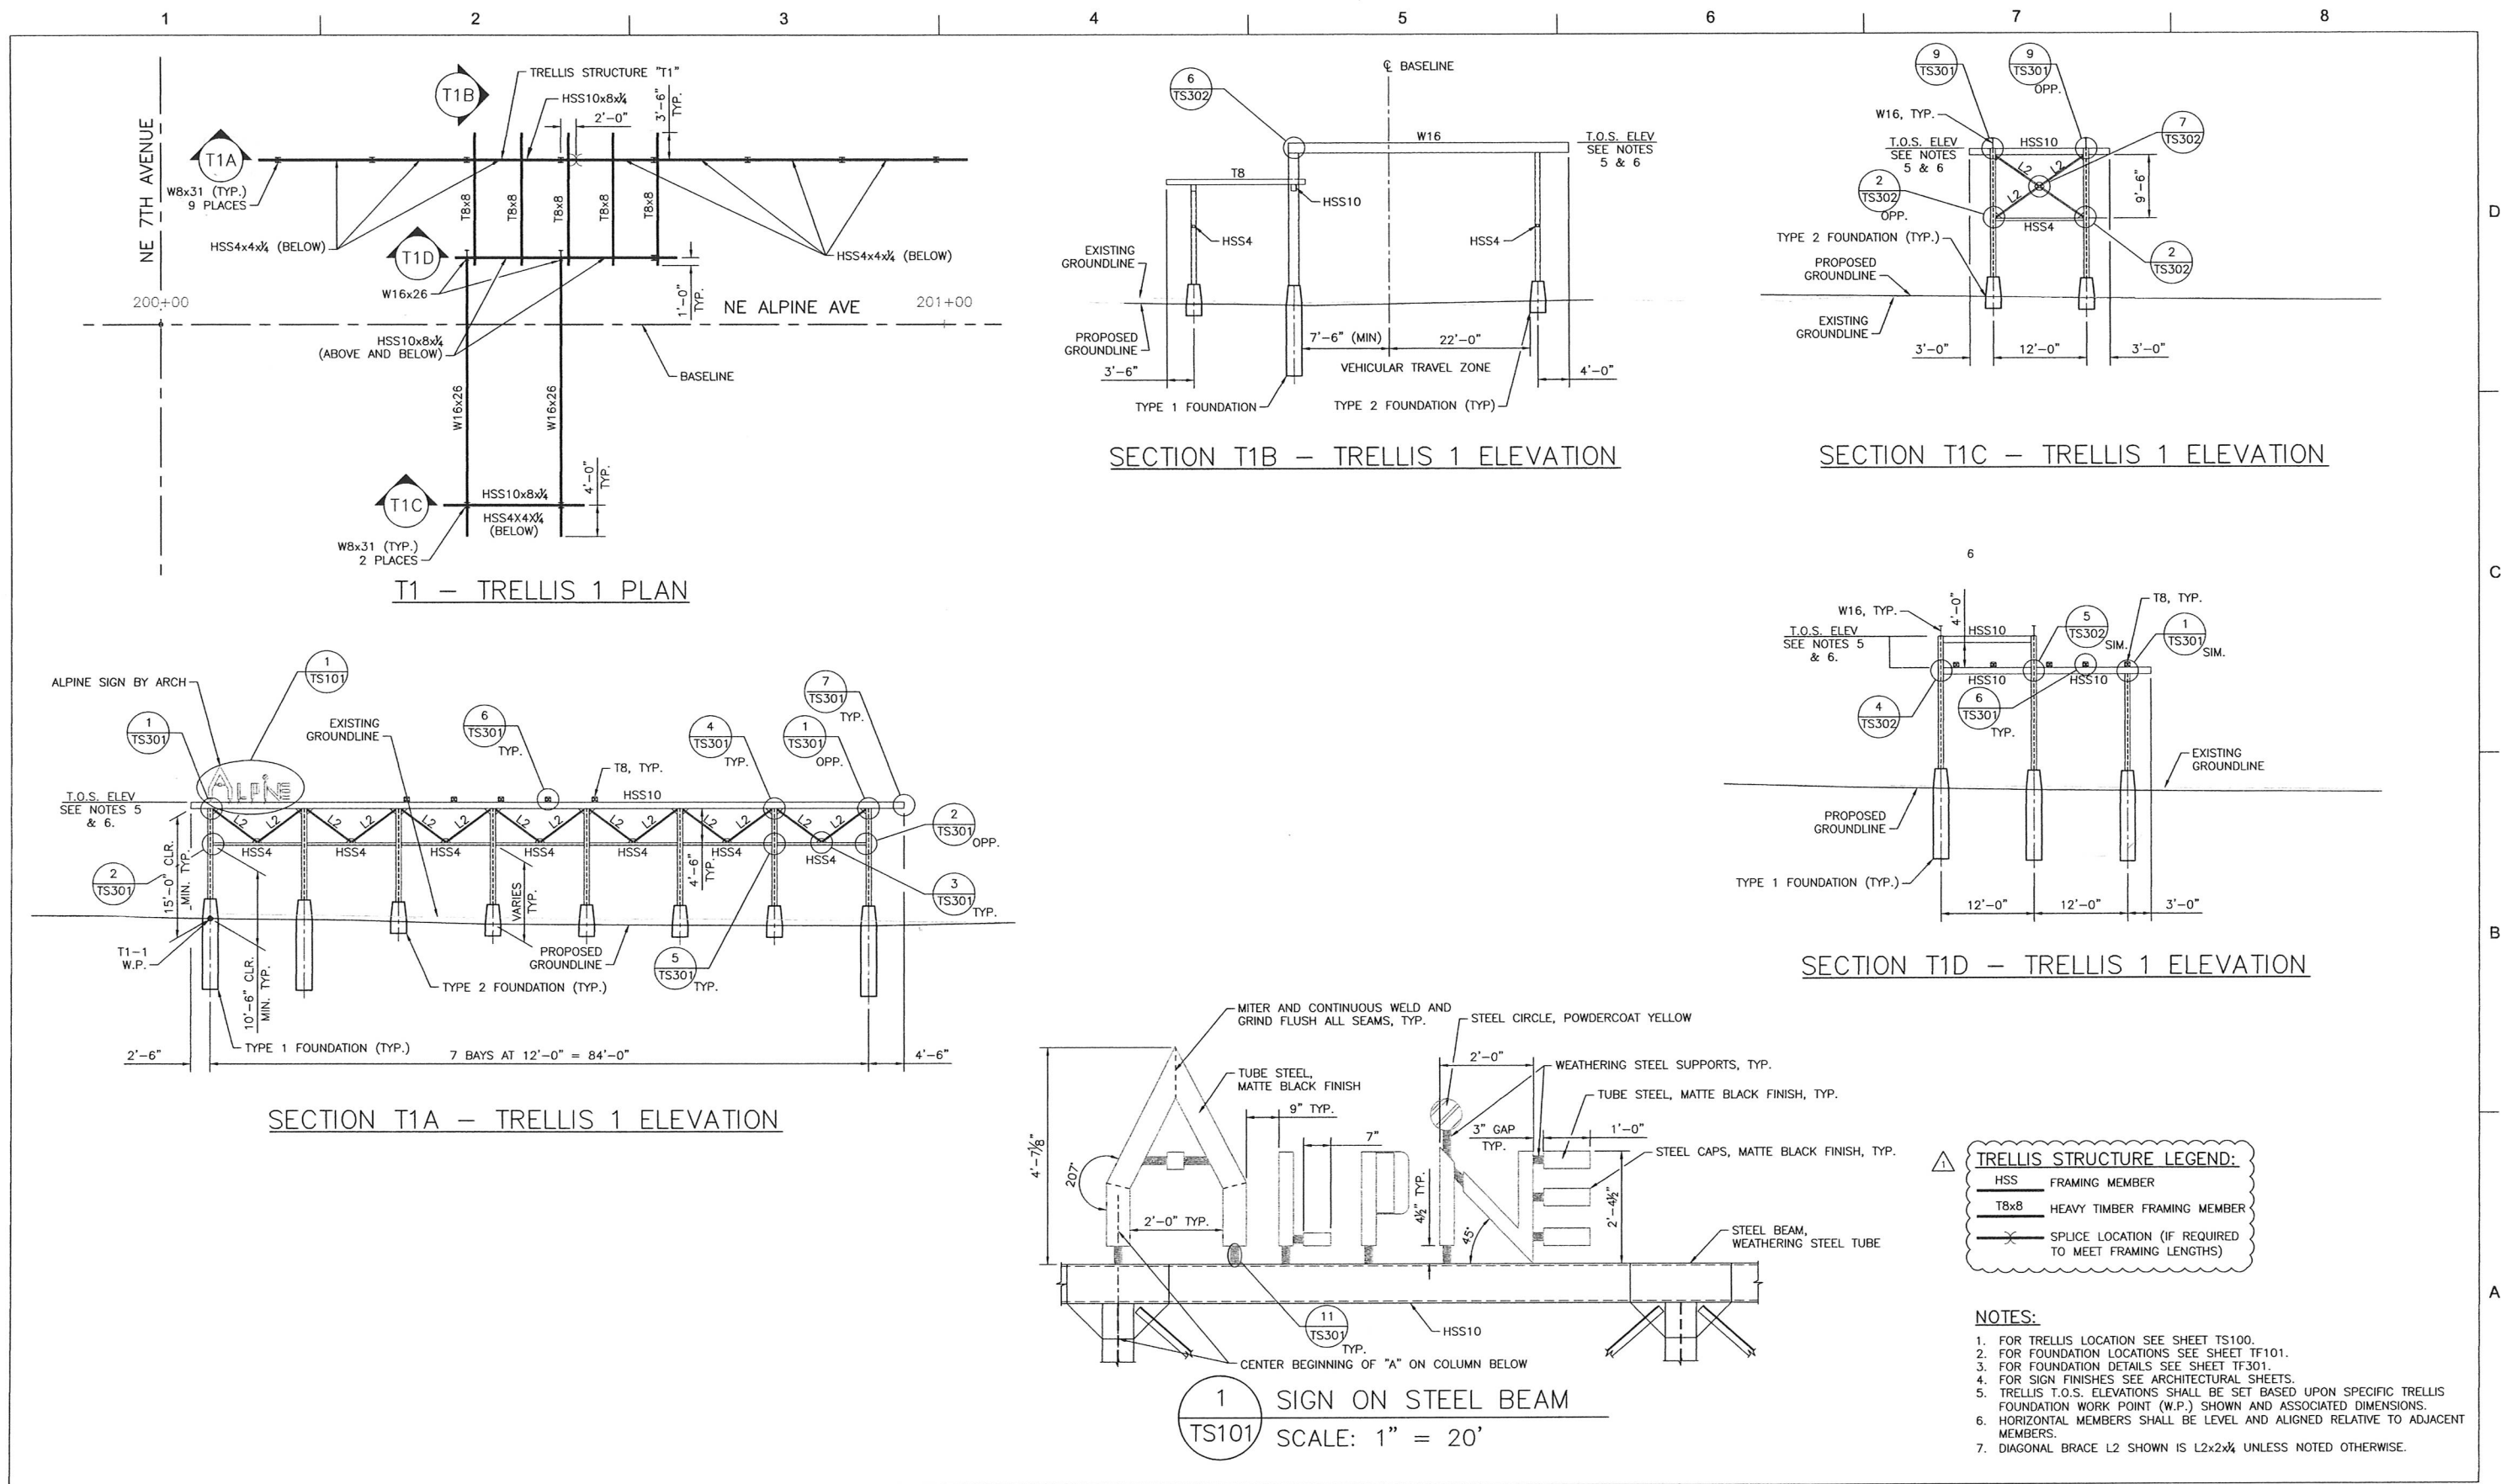




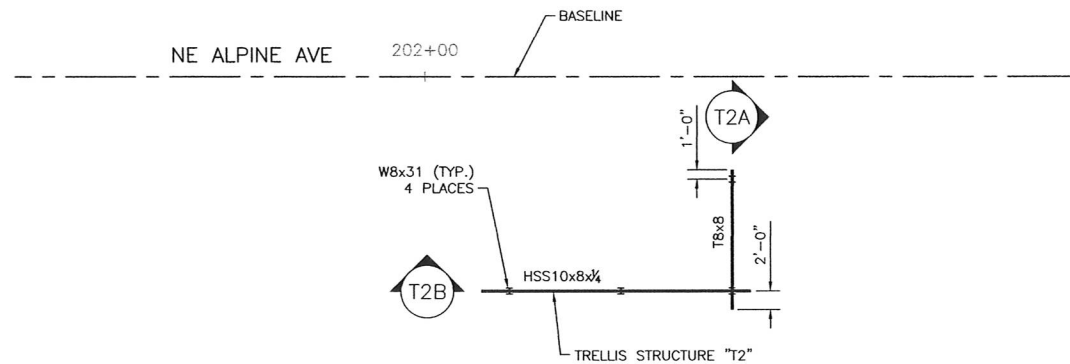

T2 – TRELLIS 2 PLAN

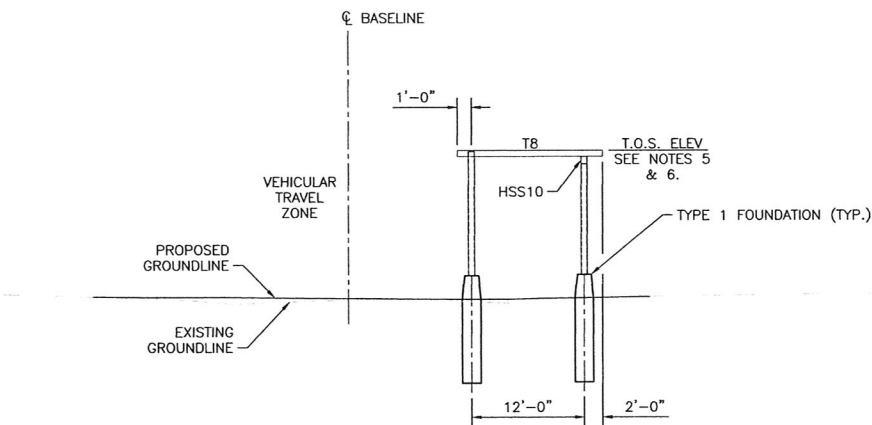

SECTION T2A – TRELLIS 2 ELEVATION

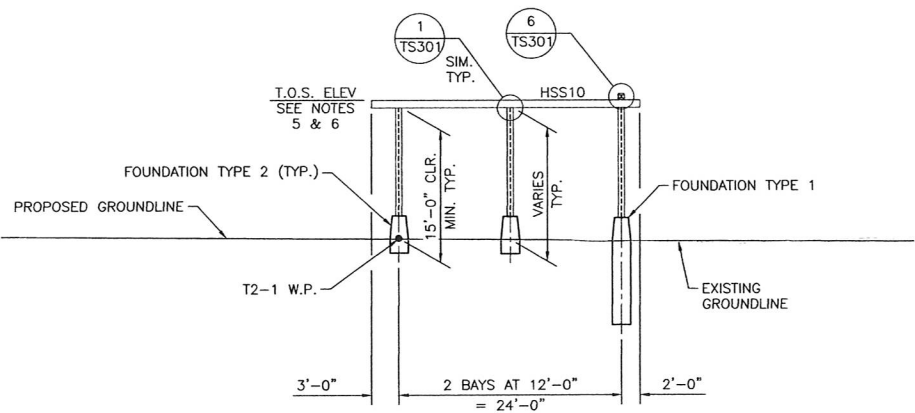

SECTION T2B – TRELLIS 2 ELEVATION

**TRELLIS STRUCTURE LEGEND:**

- HSS FRAMING MEMBER
- T8x8 HEAVY TIMBER FRAMING MEMBER
- X— SPLICE LOCATION (IF REQUIRED TO MEET FRAMING LENGTHS)

- NOTES:**
1. FOR TRELLIS LOCATION SEE SHEET TS100.
  2. FOR FOUNDATION LOCATIONS SEE SHEET TF101.
  3. FOR FOUNDATION DETAILS SEE SHEET TF301.
  4. FOR SIGN FINISHES SEE ARCHITECTURAL SHEETS.
  5. TRELLIS T.O.S. ELEVATIONS SHALL BE SET BASED UPON SPECIFIC TRELLIS FOUNDATION WORK POINT (W.P.) SHOWN AND ASSOCIATED DIMENSIONS.
  6. HORIZONTAL MEMBERS SHALL BE LEVEL AND ALIGNED RELATIVE TO ADJACENT MEMBERS.
  7. DIAGONAL BRACE L2 SHOWN IS L2x2x1/4 UNLESS NOTED OTHERWISE.



ISSUE	DATE	DESCRIPTION
1	1-26-17	REVISED LEGEND

PROJECT MANAGER	STEPHANIE SERPICO, P.E.
PROJECT NUMBER	2016-8




CITY OF MCMINNVILLE  
NE ALPINE AVENUE IMPROVEMENTS  
TRELLIS 2 PLAN AND ELEVATION  
NE ALPINE AVENUE



HORIZONTAL SCALE  
0 10 20  
1" = 10'

DATE 12/2016 SHEET TS102

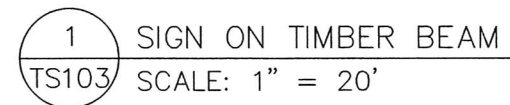

NOTES:

1. FOR TRELLIS LOCATION SEE SHEET TS100.
2. FOR FOUNDATION LOCATIONS SEE SHEET TF102.
3. FOR FOUNDATION DETAILS SEE SHEET TF301.
4. FOR SIGN FINISHES SEE ARCHITECTURAL SHEETS.
5. TRELLIS T.O.S. ELEVATIONS SHALL BE SET BASED UPON SPECIFIC TRELLIS FOUNDATION WORK POINT (W.P.) SHOWN AND ASSOCIATED DIMENSIONS.
6. HORIZONTAL MEMBERS SHALL BE LEVEL AND ALIGNED RELATIVE TO ADJACENT MEMBERS.
7. DIAGONAL BRACE L2 SHOWN IS L2x2x4 UNLESS NOTED OTHERWISE.



1	1-26-17	REVISED NOTE AND LEGEND
<b>ISSUE</b>	<b>DATE</b>	<b>DESCRIPTION</b>

**PROJECT MANAGER** STEPHANIE SERPICO, P.E.

<b>PROJECT NUMBER</b>	2016-8



**CITY OF MC MINNVILLE**  
**NE ALPINE AVENUE IMPROVEMENTS**  
**TRELLIS 3 PLAN AND ELEVATION**  
**NE ALPINE AVENUE**




HORIZONTAL SCALE




DATE 12/2016 SHEET TS103




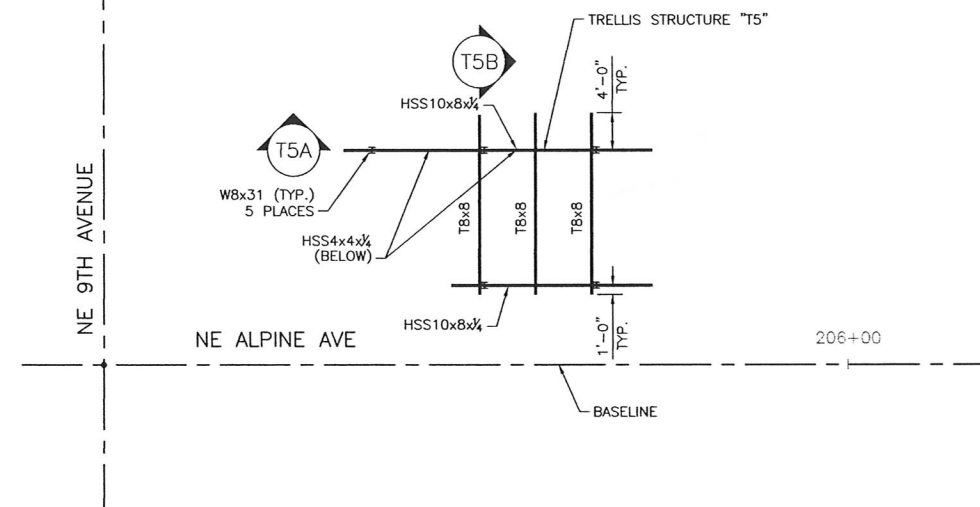

T5 - TRELLIS 5 PLAN

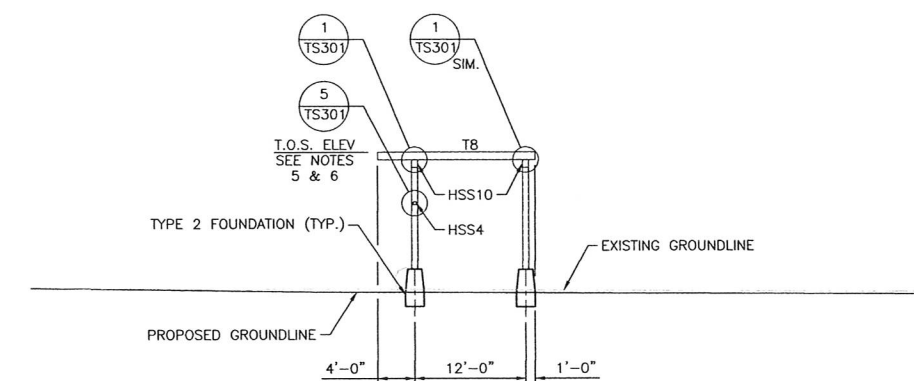

SECTION T5B - TRELLIS 5 ELEVATION

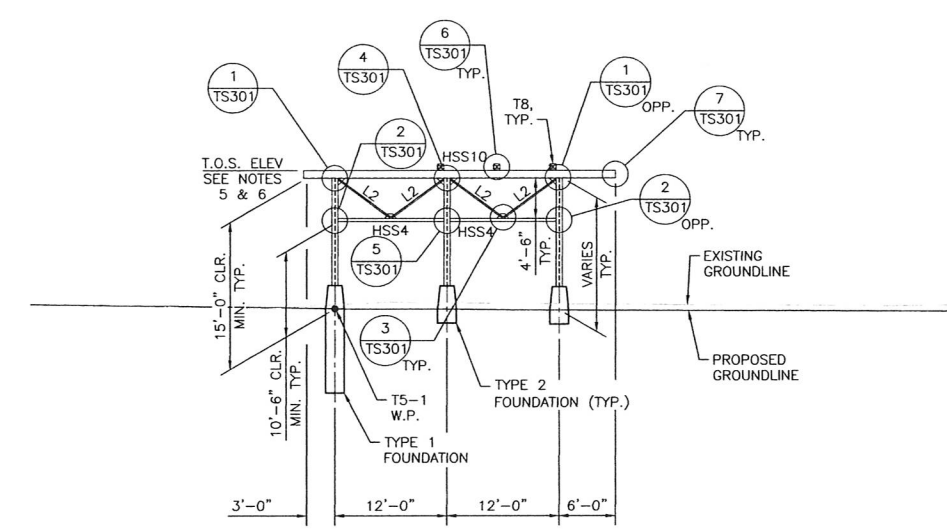

SECTION T5A - TRELLIS 5 ELEVATION

**TRELLIS STRUCTURE LEGEND:**

- HSS FRAMING MEMBER
- T8x8 HEAVY TIMBER FRAMING MEMBER
- SPLICE LOCATION (IF REQUIRED TO MEET FRAMING LENGTHS)

- NOTES:**
1. FOR TRELLIS LOCATION SEE SHEET TS100.
  2. FOR FOUNDATION LOCATIONS SEE SHEET TF103.
  3. FOR FOUNDATION DETAILS SEE SHEET TF301.
  4. FOR SIGN FINISHES SEE ARCHITECTURAL SHEETS.
  5. TRELLIS T.O.S. ELEVATIONS SHALL BE SET BASED UPON SPECIFIC TRELLIS FOUNDATION WORKPOINT (W.P.) SHOWN AND ASSOCIATED DIMENSIONS.
  6. HORIZONTAL MEMBERS SHALL BE LEVEL AND ALIGNED RELATIVE TO ADJACENT MEMBERS.
  7. DIAGONAL BRACE2 SHOWN IS L2x2x1/4 UNLESS NOTED OTHERWISE.



ISSUE	DATE	DESCRIPTION
1	1-26-17	REVISED LEGEND


PROJECT MANAGER	STEPHANIE SERPICO, P.E.
PROJECT NUMBER	2016-8




CITY OF MCMINNVILLE  
NE ALPINE AVENUE IMPROVEMENTS  
TRELLIS 5 PLAN AND ELEVATION  
NE ALPINE AVENUE

HORIZONTAL SCALE 1" = 10'


DATE 12/2016 SHEET TS104

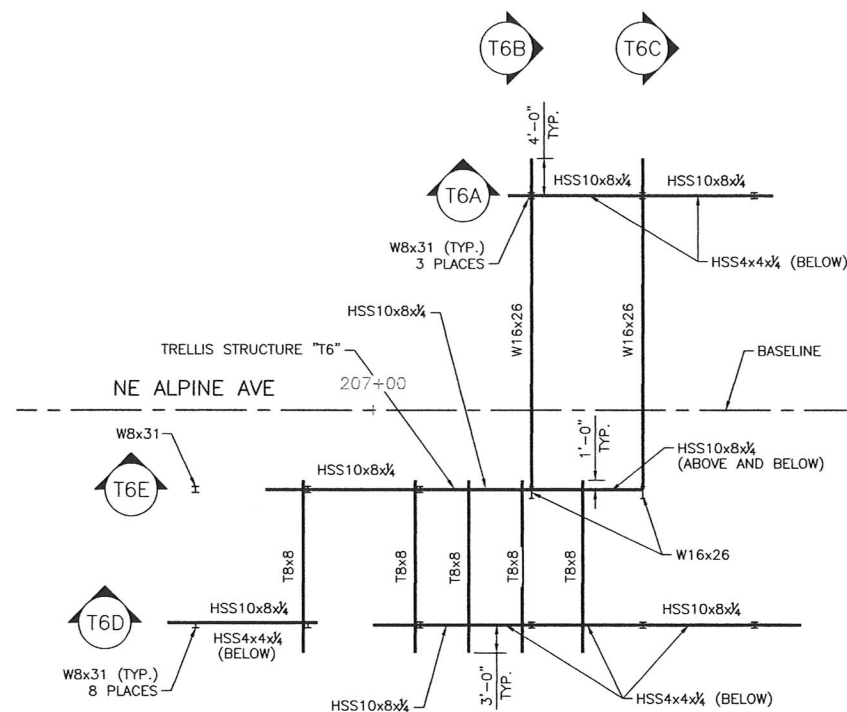


T6 - TRELLIS 6 PLAN

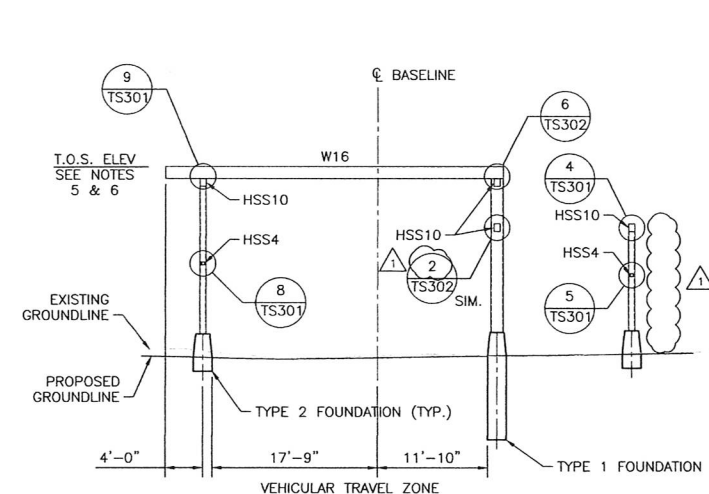


SECTION T6C - TRELLIS 6 ELEVATION

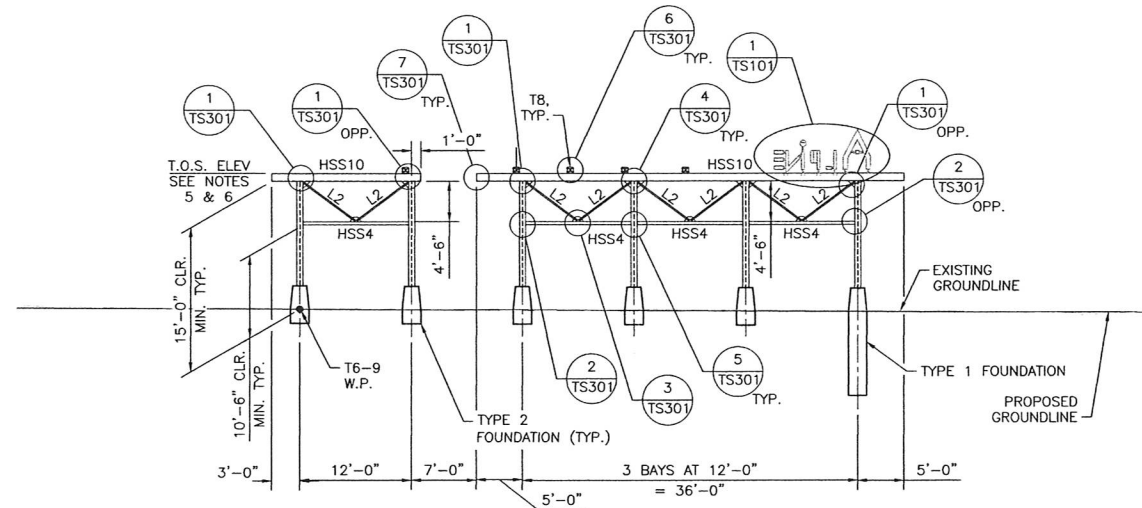


SECTION T6D - TRELLIS 6 ELEVATION

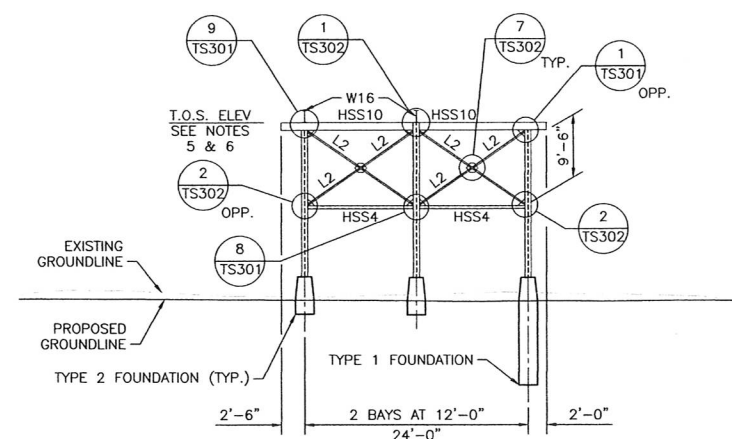


SECTION T6A - TRELLIS 6 ELEVATION

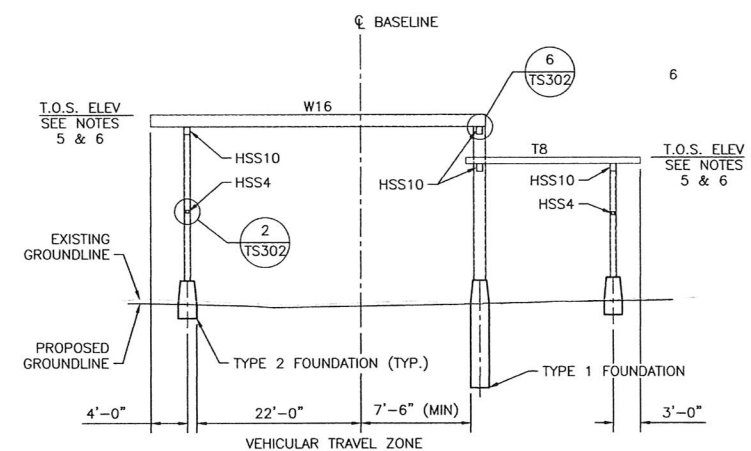

SECTION T6B - TRELLIS 6 ELEVATION

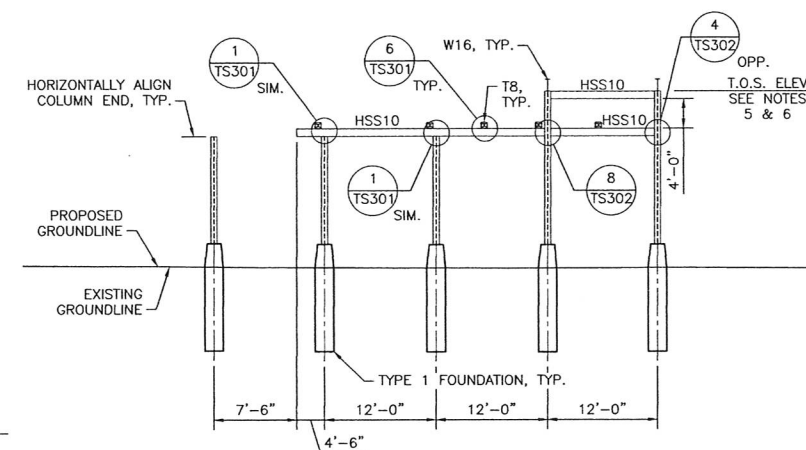

SECTION T6E - TRELLIS 6 ELEVATION

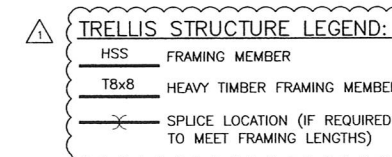

NOTES:


1. FOR TRELLIS LOCATION SEE SHEET TS100.
2. FOR FOUNDATION LOCATIONS SEE SHEET TF103.
3. FOR FOUNDATION DETAILS SEE SHEET TF301.
4. FOR SIGN FINISHES SEE ARCHITECTURAL SHEETS.
5. TRELLIS T.O.S. ELEVATIONS SHALL BE SET BASED UPON SPECIFIC TRELLIS FOUNDATION WORKPOINT (W.P.) SHOWN AND ASSOCIATED DIMENSIONS.
6. HORIZONTAL MEMBERS SHALL BE LEVEL AND ALIGNED RELATIVE TO ADJACENT MEMBERS.
7. DIAGONAL BRACEL2 SHOWN IS L2x2x1/4 UNLESS NOTED OTHERWISE.



ISSUE	DATE	DESCRIPTION
1	1-26-17	REVISED NOTES AND LEGEND

PROJECT MANAGER STEPHANIE SERPICO, P.E.

PROJECT NUMBER 2016-8

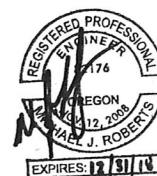


CITY OF MCMINNVILLE  
NE ALPINE AVENUE IMPROVEMENTS  
TRELLIS 6 PLAN AND ELEVATION  
NE ALPINE AVENUE



HORIZONTAL SCALE

0 10 20 FEET  
1" = 10'

DATE 12/2016 SHEET TS105

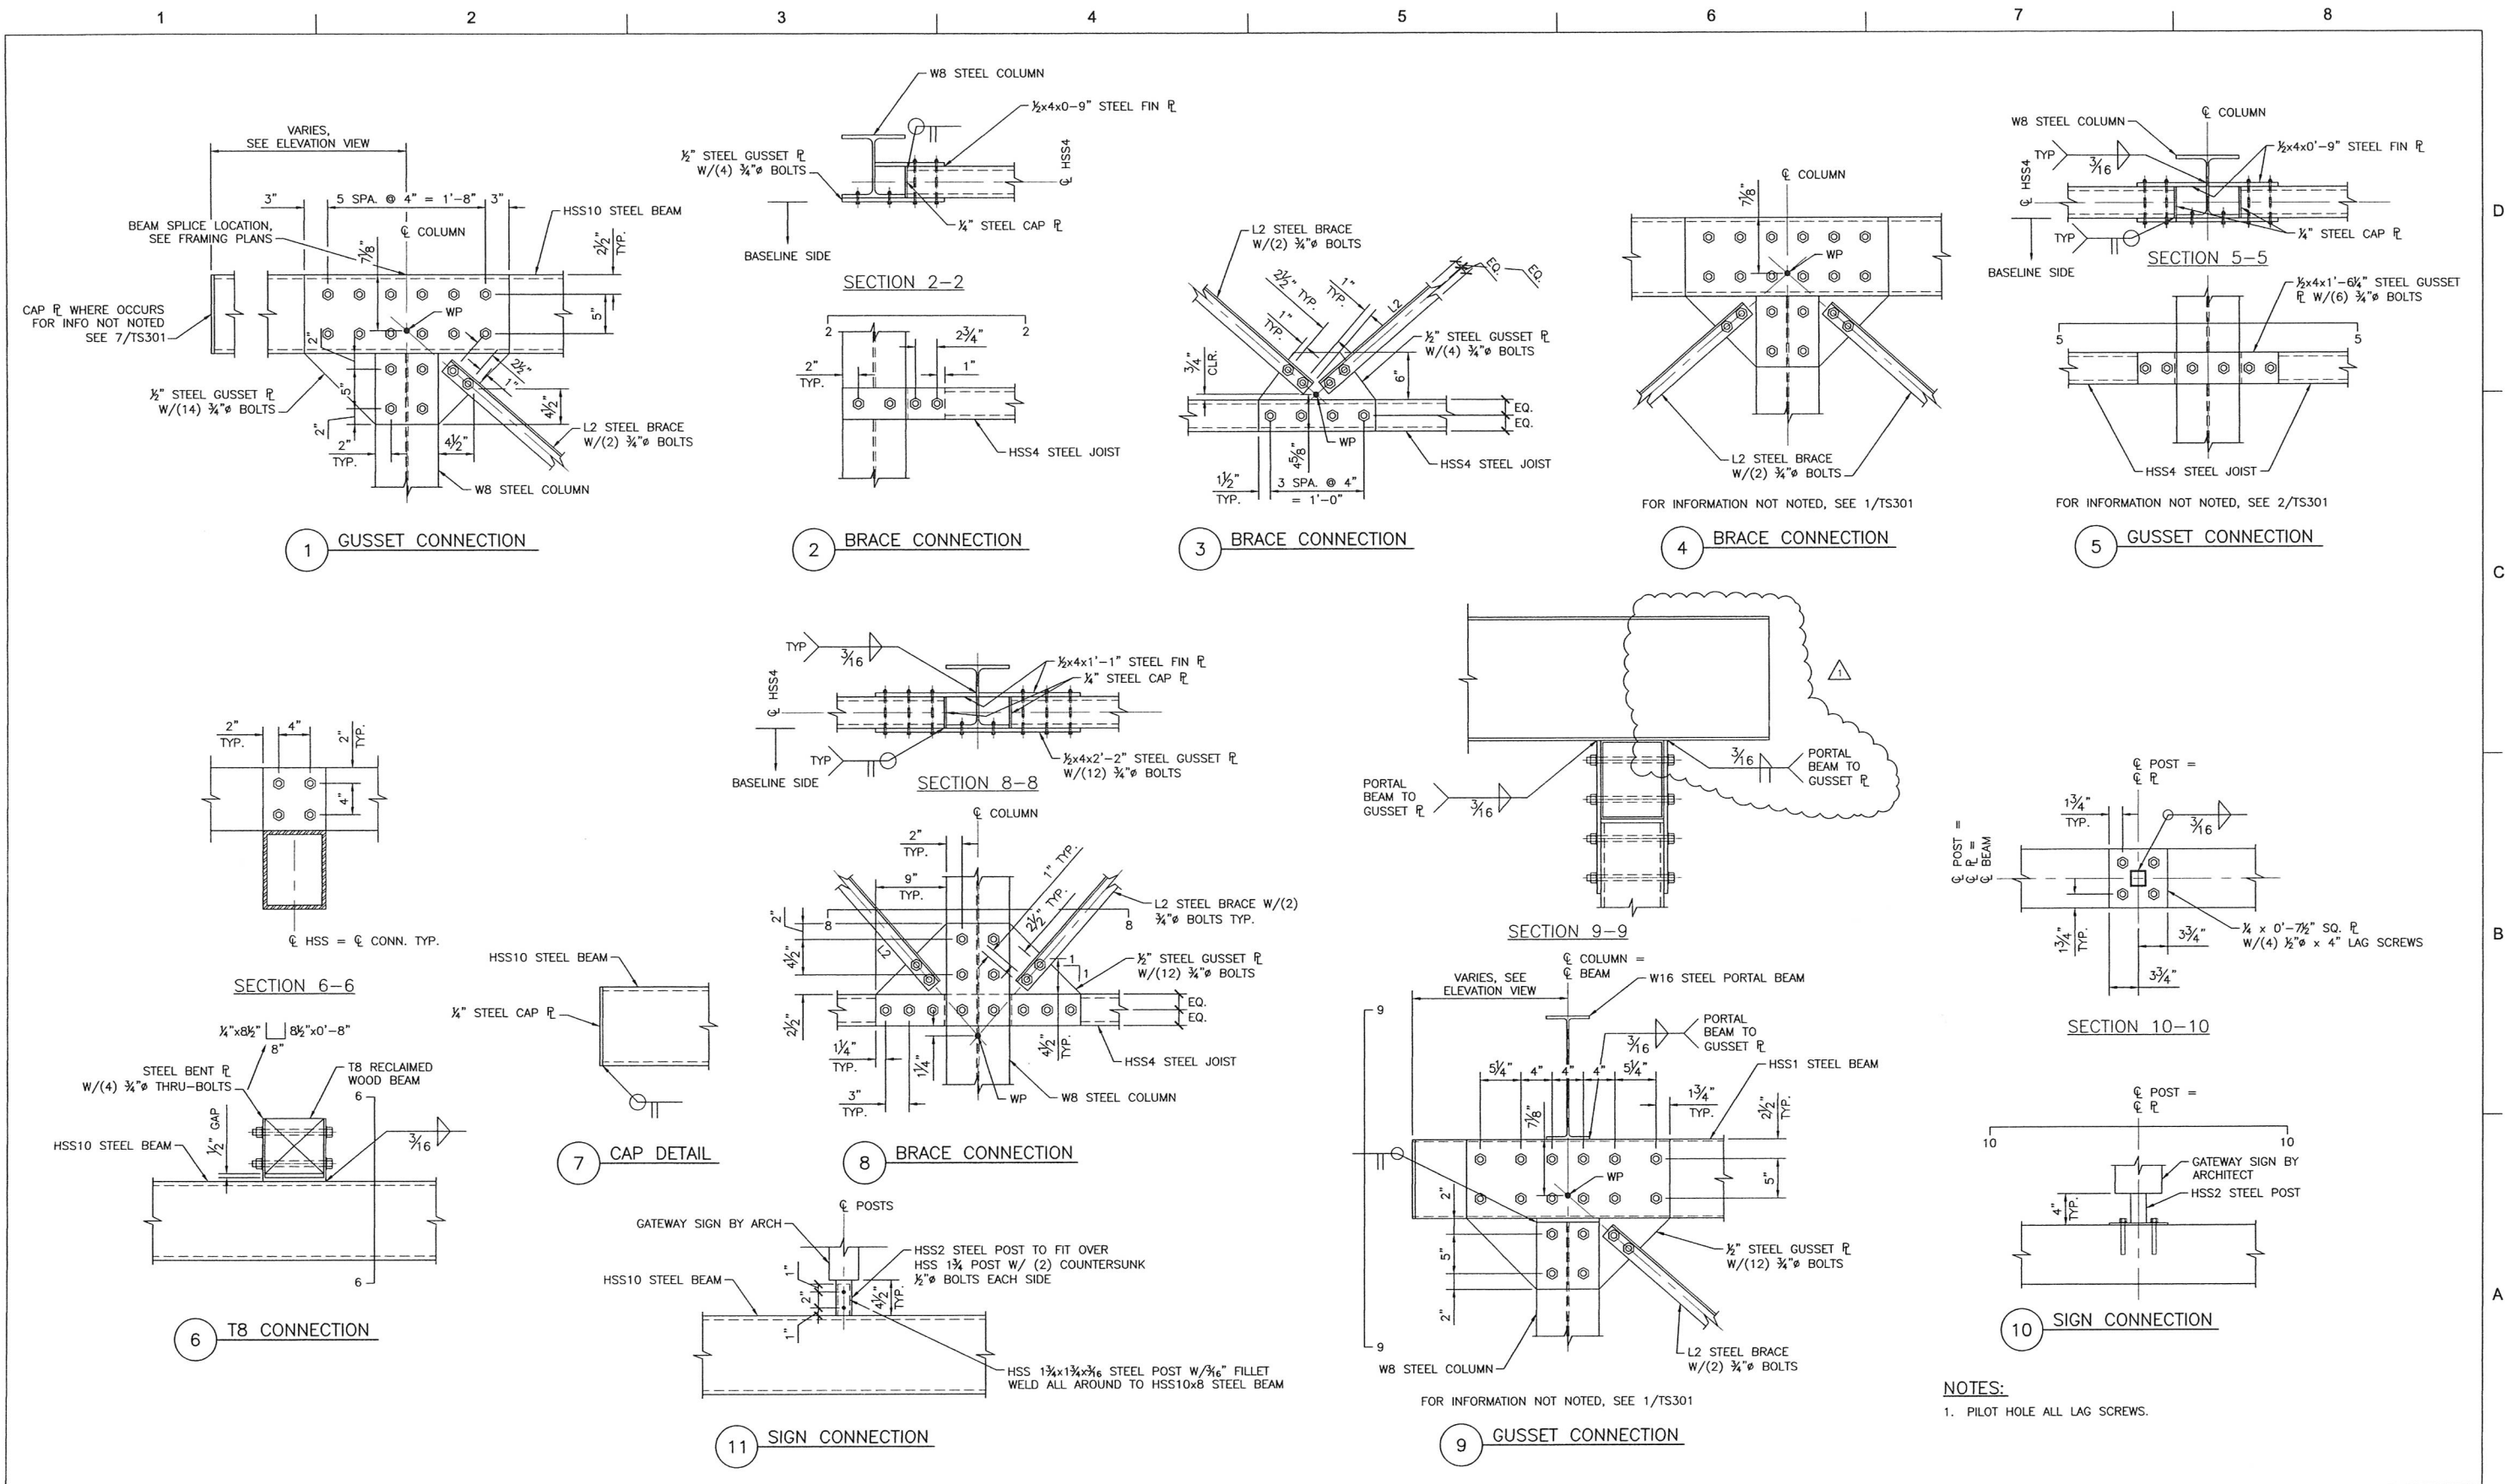

ISSUE	DATE	DESCRIPTION
1	1-26-17	REVISED DETAIL

PROJECT MANAGER STEPHANIE SERPICO, P.E.

PROJECT NUMBER 2016-8



**CITY OF MCMINNVILLE**  
**NE ALPINE AVENUE IMPROVEMENTS**  
**FRAMING DETAILS**  
**NE ALPINE AVENUE STA: 205+12 TO 207+50**

HORIZONTAL SCALE


NO SCALE

DATE 12/2016

SHEET TS301





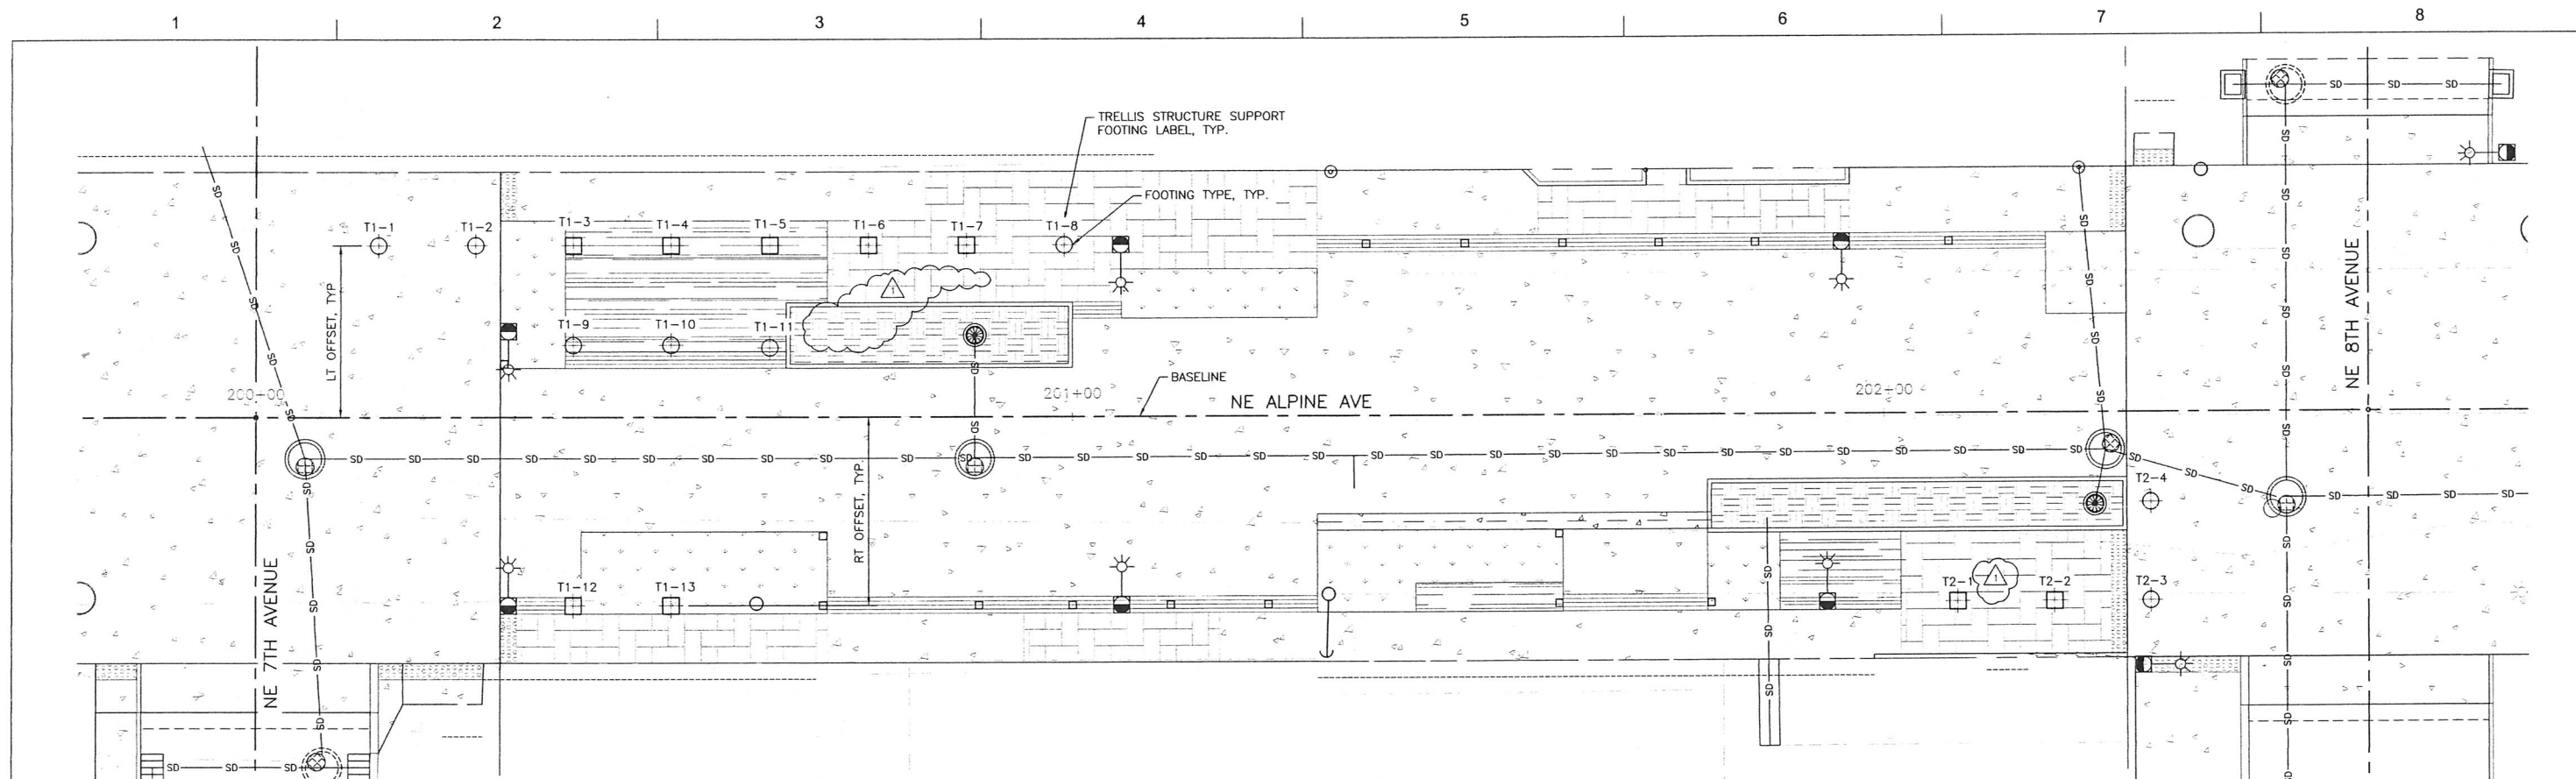

#### NOTES:

- SEE SHEET TS100 FOR GENERAL NOTES.
- TRELLIS STRUCTURE FRAMING NOT SHOWN.
- FOUNDATION PLAN LOCATIONS ARE WORK POINTS BASED UPON CENTER OF FOUNDATION AND GROUND LINE.
- SEE TF301 FOR TRELLIS STRUCTURE SUPPORT FOUNDATION ELEVATION WORKPOINTS.


#### REFERENCES:

- FOR PROJECT SHEET INDEX, SEE SHEET GN100.
- FOR GENERAL LEGEND AND ABBREVIATIONS, SEE SHEET GN101.
- FOR GENERAL CONSTRUCTION NOTES, SEE SHEET GN102.
- FOR TYPICAL NE ALPINE AVE CROSS SECTION AND PAVEMENT DETAILS, SEE "DT" SHEETS.
- FOR TRAFFIC CONTROL PLAN, SEE "TC" SHEETS.
- FOR EXISTING CONDITIONS, SURVEY, AND DEMOLITION PLANS, SEE "S" AND "D" SHEETS.
- FOR CIVIL WORKS, SEE "C" SHEETS.
- FOR PAVEMENT JOINTING DETAILS, SEE "J" SHEETS.
- SEE "GR" SHEETS FOR GRADING PLANS AND STATION, OFFSET, AND ELEVATION INFORMATION FOR ALL CURBS, GRADING, AND CRITICAL POINTS NOT SHOWN ON THIS PLAN.
- FOR STORM DRAINAGE AND UTILITY PLANS, SEE "SD" AND "U" SHEETS.
- FOR EROSION CONTROL PLANS, SEE "EC" SHEETS.
- FOR SURFACING AND STREETScape PLANS, SEE "SU" AND "ST" SHEETS.
- FOR PLANTING AND IRRIGATION PLANS, SEE "PL" AND "IR" SHEETS.
- FOR ILLUMINATION DETAILS, SEE "IL" SHEETS.
- FOR SIGNING AND STRIPING DETAILS, SEE "SS" SHEETS.
- FOR ARCHITECTURAL DETAILS, SEE "T" SHEETS.

#### LEGEND:

- WORKING POINT
- TYPE 1 - TRELLIS STRUCTURE FOUNDATION SUPPORT
- TYPE 2 - TRELLIS STRUCTURE FOUNDATION FOOTING
- (C) CONDUIT LOCATIONS: SEE "IL" AND "T" SHEETS.

#### KEYMAP:

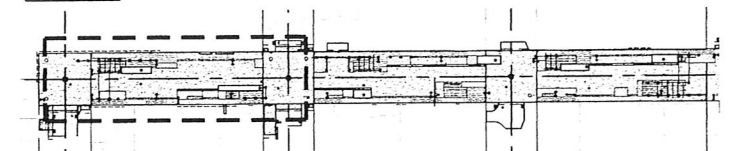

FOUNDATION TABLE - SEE NOTE 3

FOOTING	TYPE	STATION	OFFSET	ELEVATION
T1-1	1	200+15.00	21.00' LT	155.10
T1-2	1	200+27.00	21.00' LT	154.97
T1-3	2	200+39.00	21.00' LT	154.72
T1-4	2	200+51.00	21.00' LT	154.39
T1-5	2	200+63.00	21.00' LT	154.33
T1-6	2	200+75.00	21.00' LT	154.24
T1-7	2	200+87.00	21.00' LT	154.20
T1-8	1	200+99.00	21.00' LT	154.16
T1-9	1	200+39.00	8.81' LT	154.55
T1-10	1	200+51.00	8.81' LT	154.33
T1-11(C)	1	200+63.00	8.50' LT	154.22
T1-12	2	200+39.00	23.00' RT	155.04
T1-13	2	200+51.00	23.00' RT	154.90
T2-1(C)	2	202+09.00	23.00' RT	153.85
T2-2	2	202+21.00	23.00' RT	153.78
T2-3	1	202+33.00	23.00' RT	153.60
T2-4	1	202+33.00	11.00' RT	153.45



ISSUE	DATE	DESCRIPTION
1	1-26-17	REVISED LEGEND, DELETED NOTES

PROJECT MANAGER STEPHANIE SERPICO, P.E.

PROJECT NUMBER 2016-8



CITY OF MCMINNVILLE  
NE ALPINE AVENUE IMPROVEMENTS  
TRELLIS STRUCTURE FOUNDATION PLAN  
NE ALPINE AVENUE STA: 199+73 TO 202+44




HORIZONTAL SCALE

0 10 20  
1" = 10' FEET

DATE 12/2016

SHEET TF101

1 2 3 4 5 6 7 8

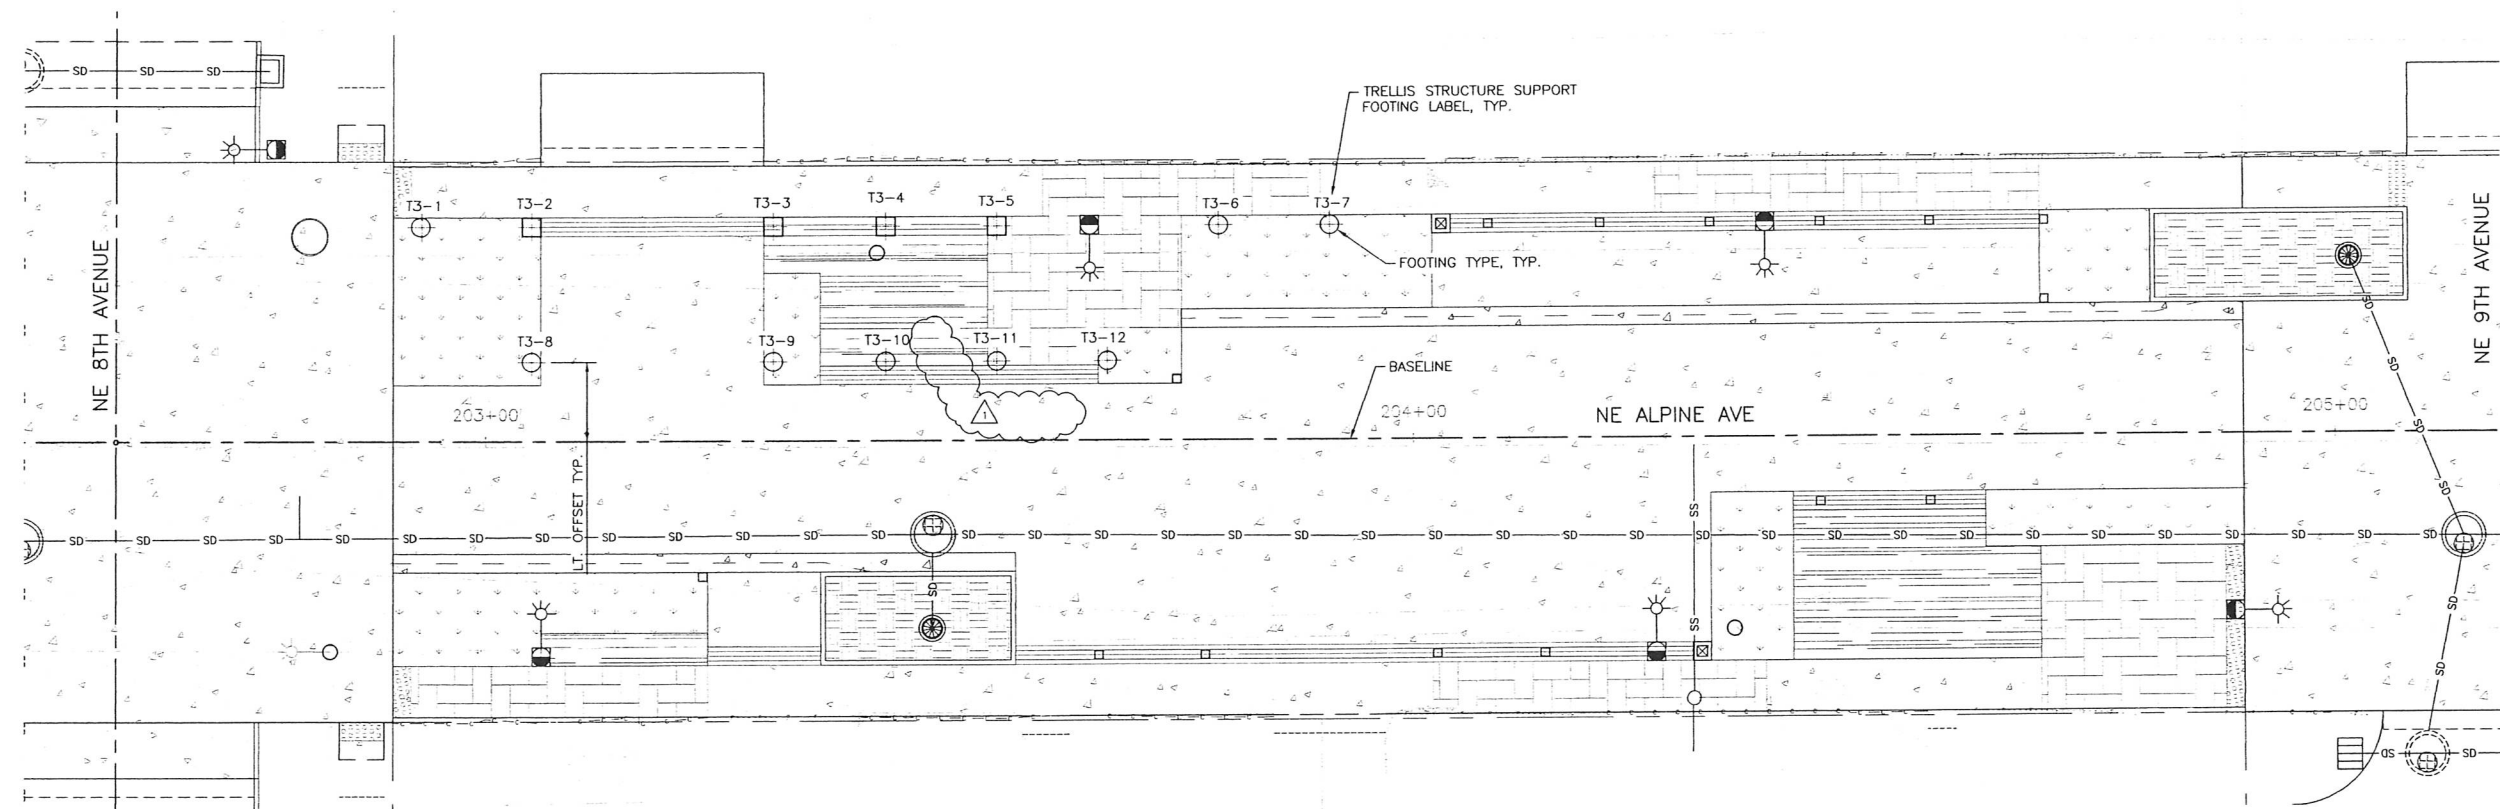

D

C

B

A

NOTES:

1. SEE SHEET TS100 FOR GENERAL NOTES.
2. TRELLIS STRUCTURE FRAMING NOT SHOWN.
3. FOUNDATION PLAN LOCATIONS ARE WORK POINTS BASED UPON CENTER OF FOUNDATION AND GROUNDLINE.
4. SEE TF301 FOR TRELLIS STRUCTURE SUPPORT FOUNDATION ELEVATION WORKPOINTS.


REFERENCES:

1. FOR PROJECT SHEET INDEX, SEE SHEET GN100.
2. FOR GENERAL LEGEND AND ABBREVIATIONS, SEE SHEET GN101.
3. FOR GENERAL CONSTRUCTION NOTES, SEE SHEET GN102.
4. FOR TYPICAL NE ALPINE AVE CROSS SECTION AND PAVEMENT DETAILS, SEE "DT" SHEETS.
5. FOR TRAFFIC CONTROL PLAN, SEE "TC" SHEETS.
6. FOR EXISTING CONDITIONS, SURVEY, AND DEMOLITION PLANS, SEE "S" AND "D" SHEETS.
7. FOR CIVIL WORKS, SEE "C" SHEETS.
8. FOR PAVEMENT JOINTING DETAILS, SEE "J" SHEETS.
9. SEE "GR" SHEETS FOR GRADING PLANS AND STATION, OFFSET, AND ELEVATION INFORMATION FOR ALL CURBS, GRADING, AND CRITICAL POINTS NOT SHOWN ON THIS PLAN.
10. FOR STORM DRAINAGE AND UTILITY PLANS, SEE "SD" AND "U" SHEETS.
11. FOR EROSION CONTROL PLANS, SEE "EC" SHEETS.
12. FOR SURFACING AND STREETSCAPE PLANS, SEE "SU" AND "ST" SHEETS.
13. FOR PLANTING AND IRRIGATION PLANS, SEE "PL" AND "IR" SHEETS.
14. FOR ILLUMINATION DETAILS, SEE "IL" SHEETS.
15. FOR SIGNING AND STRIPING DETAILS, SEE "SS" SHEETS.
16. FOR ARCHITECTURAL DETAILS, SEE "T" SHEETS.

LEGEND:

- WORKING POINT
- TYPE 1 - TRELLIS STRUCTURE FOUNDATION SUPPORT
  - TYPE 2 - TRELLIS STRUCTURE FOUNDATION FOOTING
  - (C) CONDUIT LOCATIONS: SEE "IL" AND "T" SHEETS.

KEYMAP:

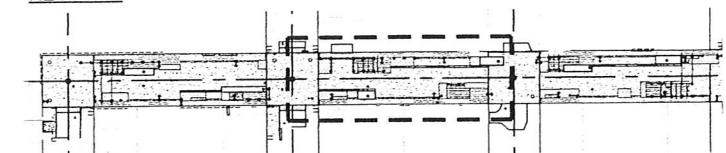

FOUNDATION TABLE - SEE NOTE 3

FOOTING	TYPE	STATION	OFFSET	ELEVATION
T3-1	1	202+93.00	23.00' LT	153.43
T3-2	2	203+05.00	23.00' LT	153.33
T3-3	2	203+31.00	23.00' LT	153.16
T3-4	2	203+43.00	23.00' LT	153.07
T3-5	2	203+55.00	23.00' LT	152.95
T3-6	1	203+79.00	23.00' LT	152.69
T3-7	1	203+91.00	23.00' LT	152.53
T3-8	1	203+05.00	8.50' LT	153.26
T3-9	1	203+31.00	8.50' LT	153.09
T3-10(C)	1	203+43.00	8.50' LT	152.99
T3-11	1	203+55.00	8.50' LT	152.87
T3-12	1	203+67.00	8.50' LT	152.68



ISSUE	DATE	DESCRIPTION
1	1-26-17	REVISED LEGEND, DELETED NOTE

PROJECT MANAGER STEPHANIE SERPICO, P.E.

PROJECT NUMBER 2016-8



CITY OF MCMINNVILLE  
NE ALPINE AVENUE IMPROVEMENTS  
TRELLIS STRUCTURE FOUNDATION PLAN  
NE ALPINE AVENUE STA: 202+44 TO 205+12



HORIZONTAL SCALE 0 10 20 FEET  
1" = 10'

DATE 12/2016 SHEET TF102

1

2

3


4

5

6

7

8

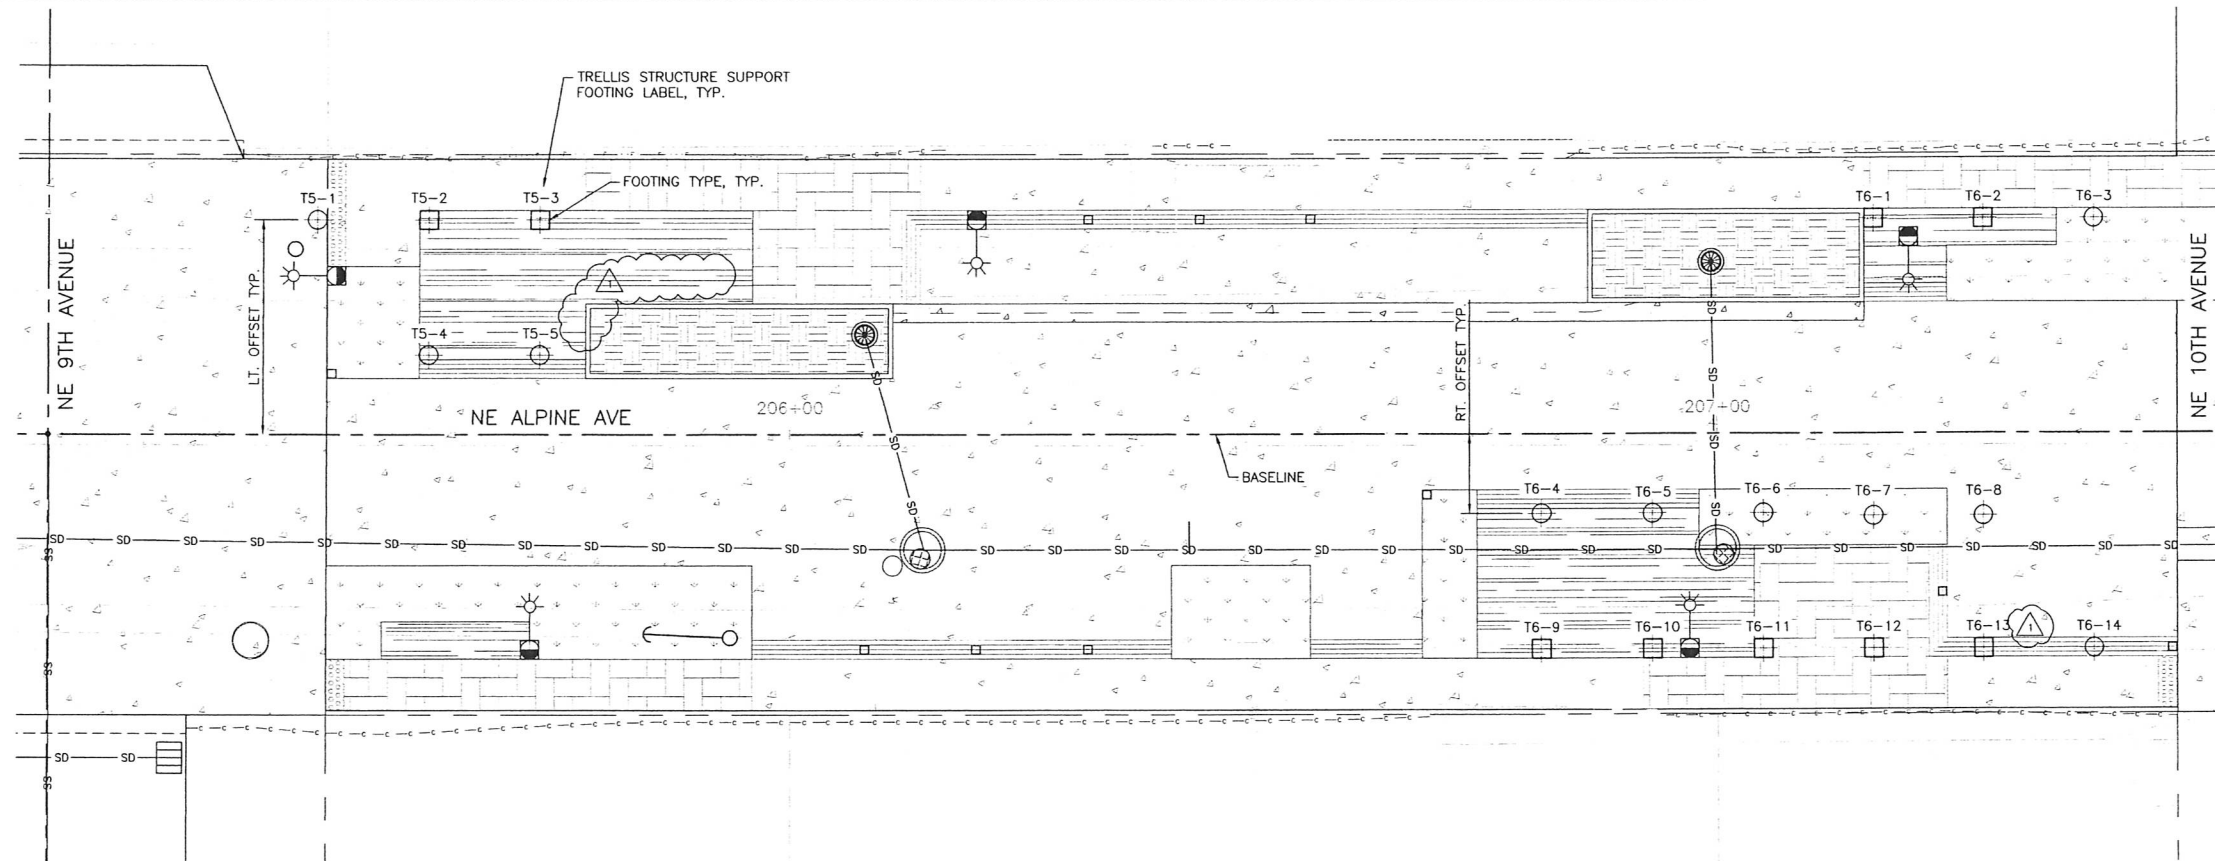

D

C

B

A

FOUNDATION TABLE - SEE NOTE 3

FOOTING	TYPE	STATION	OFFSET	ELEVATION
T5-1	1	205+49.00	23.00' LT	150.89
T5-2	2	205+61.00	23.00' LT	150.86
T5-3	2	205+73.00	23.00' LT	150.74
T5-4	1	205+61.00	8.50' LT	150.69
T5-5(C)	1	205+73.00	8.50' LT	150.55
T6-1	2	207+17.00	23.00' LT	150.01
T6-2	2	207+29.00	23.00' LT	149.92
T6-3	1	207+41.00	23.00' LT	149.90
T6-4	1	206+81.00	8.50' RT	150.22
T6-5	1	206+93.00	8.50' RT	150.13
T6-6	1	207+05.00	8.50' RT	150.09
T6-7	1	207+17.00	8.81' RT	150.08
T6-8	1	207+29.00	8.81' RT	150.11
T6-9	2	206+81.00	23.00' RT	150.52
T6-10	2	206+93.00	23.00' RT	150.47
T6-11	2	207+05.00	23.00' RT	150.41
T6-12	2	207+17.00	23.00' RT	150.35
T6-13(C)	2	207+29.00	23.00' RT	150.29
T6-14	2	207+41.00	23.00' RT	150.23

## NOTES:

- SEE SHEET TS100 FOR GENERAL NOTES.
- TRELLIS STRUCTURE FRAMING NOT SHOWN.
- FOUNDATION PLAN LOCATIONS ARE WORK POINTS BASED UPON CENTER OF FOUNDATION AND GROUNDLINE.
- SEE TF301 FOR TRELLIS STRUCTURE SUPPORT FOUNDATION ELEVATION WORKPOINTS.


## REFERENCES:

- FOR PROJECT SHEET INDEX, SEE SHEET GN100.
- FOR GENERAL LEGEND AND ABBREVIATIONS, SEE SHEET GN101.
- FOR GENERAL CONSTRUCTION NOTES, SEE SHEET GN102.
- FOR TYPICAL NE ALPINE AVE CROSS SECTION AND PAVEMENT DETAILS, SEE "DT" SHEETS.
- FOR TRAFFIC CONTROL PLAN, SEE "TC" SHEETS.
- FOR EXISTING CONDITIONS, SURVEY, AND DEMOLITION PLANS, SEE "S" AND "D" SHEETS.
- FOR CIVIL WORKS, SEE "C" SHEETS.
- FOR PAVEMENT JOINTING DETAILS, SEE "J" SHEETS.
- SEE "GR" SHEETS FOR GRADING PLANS AND STATION, OFFSET, AND ELEVATION INFORMATION FOR ALL CURBS, GRADING, AND CRITICAL POINTS NOT SHOWN ON THIS PLAN.
- FOR STORM DRAINAGE AND UTILITY PLANS, SEE "SD" AND "U" SHEETS.
- FOR EROSION CONTROL PLANS, SEE "EC" SHEETS.
- FOR SURFACING AND STREETSCAPE PLANS, SEE "SU" AND "ST" SHEETS.
- FOR PLANTING AND IRRIGATION PLANS, SEE "PL" AND "IR" SHEETS.
- FOR ILLUMINATION DETAILS, SEE "IL" SHEETS.
- FOR SIGNING AND STRIPING DETAILS, SEE "SS" SHEETS.
- FOR ARCHITECTURAL DETAILS, SEE "T" SHEETS.

## LEGEND:

- WORKING POINT
- TYPE 1 - TRELLIS STRUCTURE FOUNDATION SUPPORT
- TYPE 2 - TRELLIS STRUCTURE FOUNDATION FOOTING
- (C) CONDUIT LOCATIONS: SEE "IL" AND "T" SHEETS.

## KEYMAP:

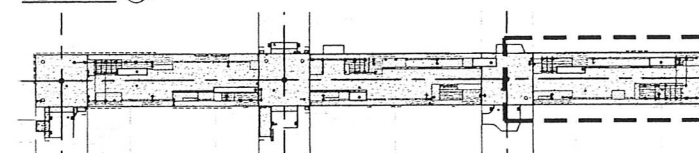

ISSUE	DATE	DESCRIPTION
1	1-26-17	REVISED LEGEND, DELETED NOTES

PROJECT MANAGER STEPHANIE SERPICO, P.E.

PROJECT NUMBER	2016-8
----------------	--------




CITY OF MCMINNVILLE  
NE ALPINE AVENUE IMPROVEMENTS  
TRELLIS STRUCTURE FOUNDATION PLAN  
NE ALPINE AVENUE STA: 205+12 TO 207+50



HORIZONTAL SCALE 0 10 20 FEET  
1" = 10'

DATE 12/2016 SHEET TF103



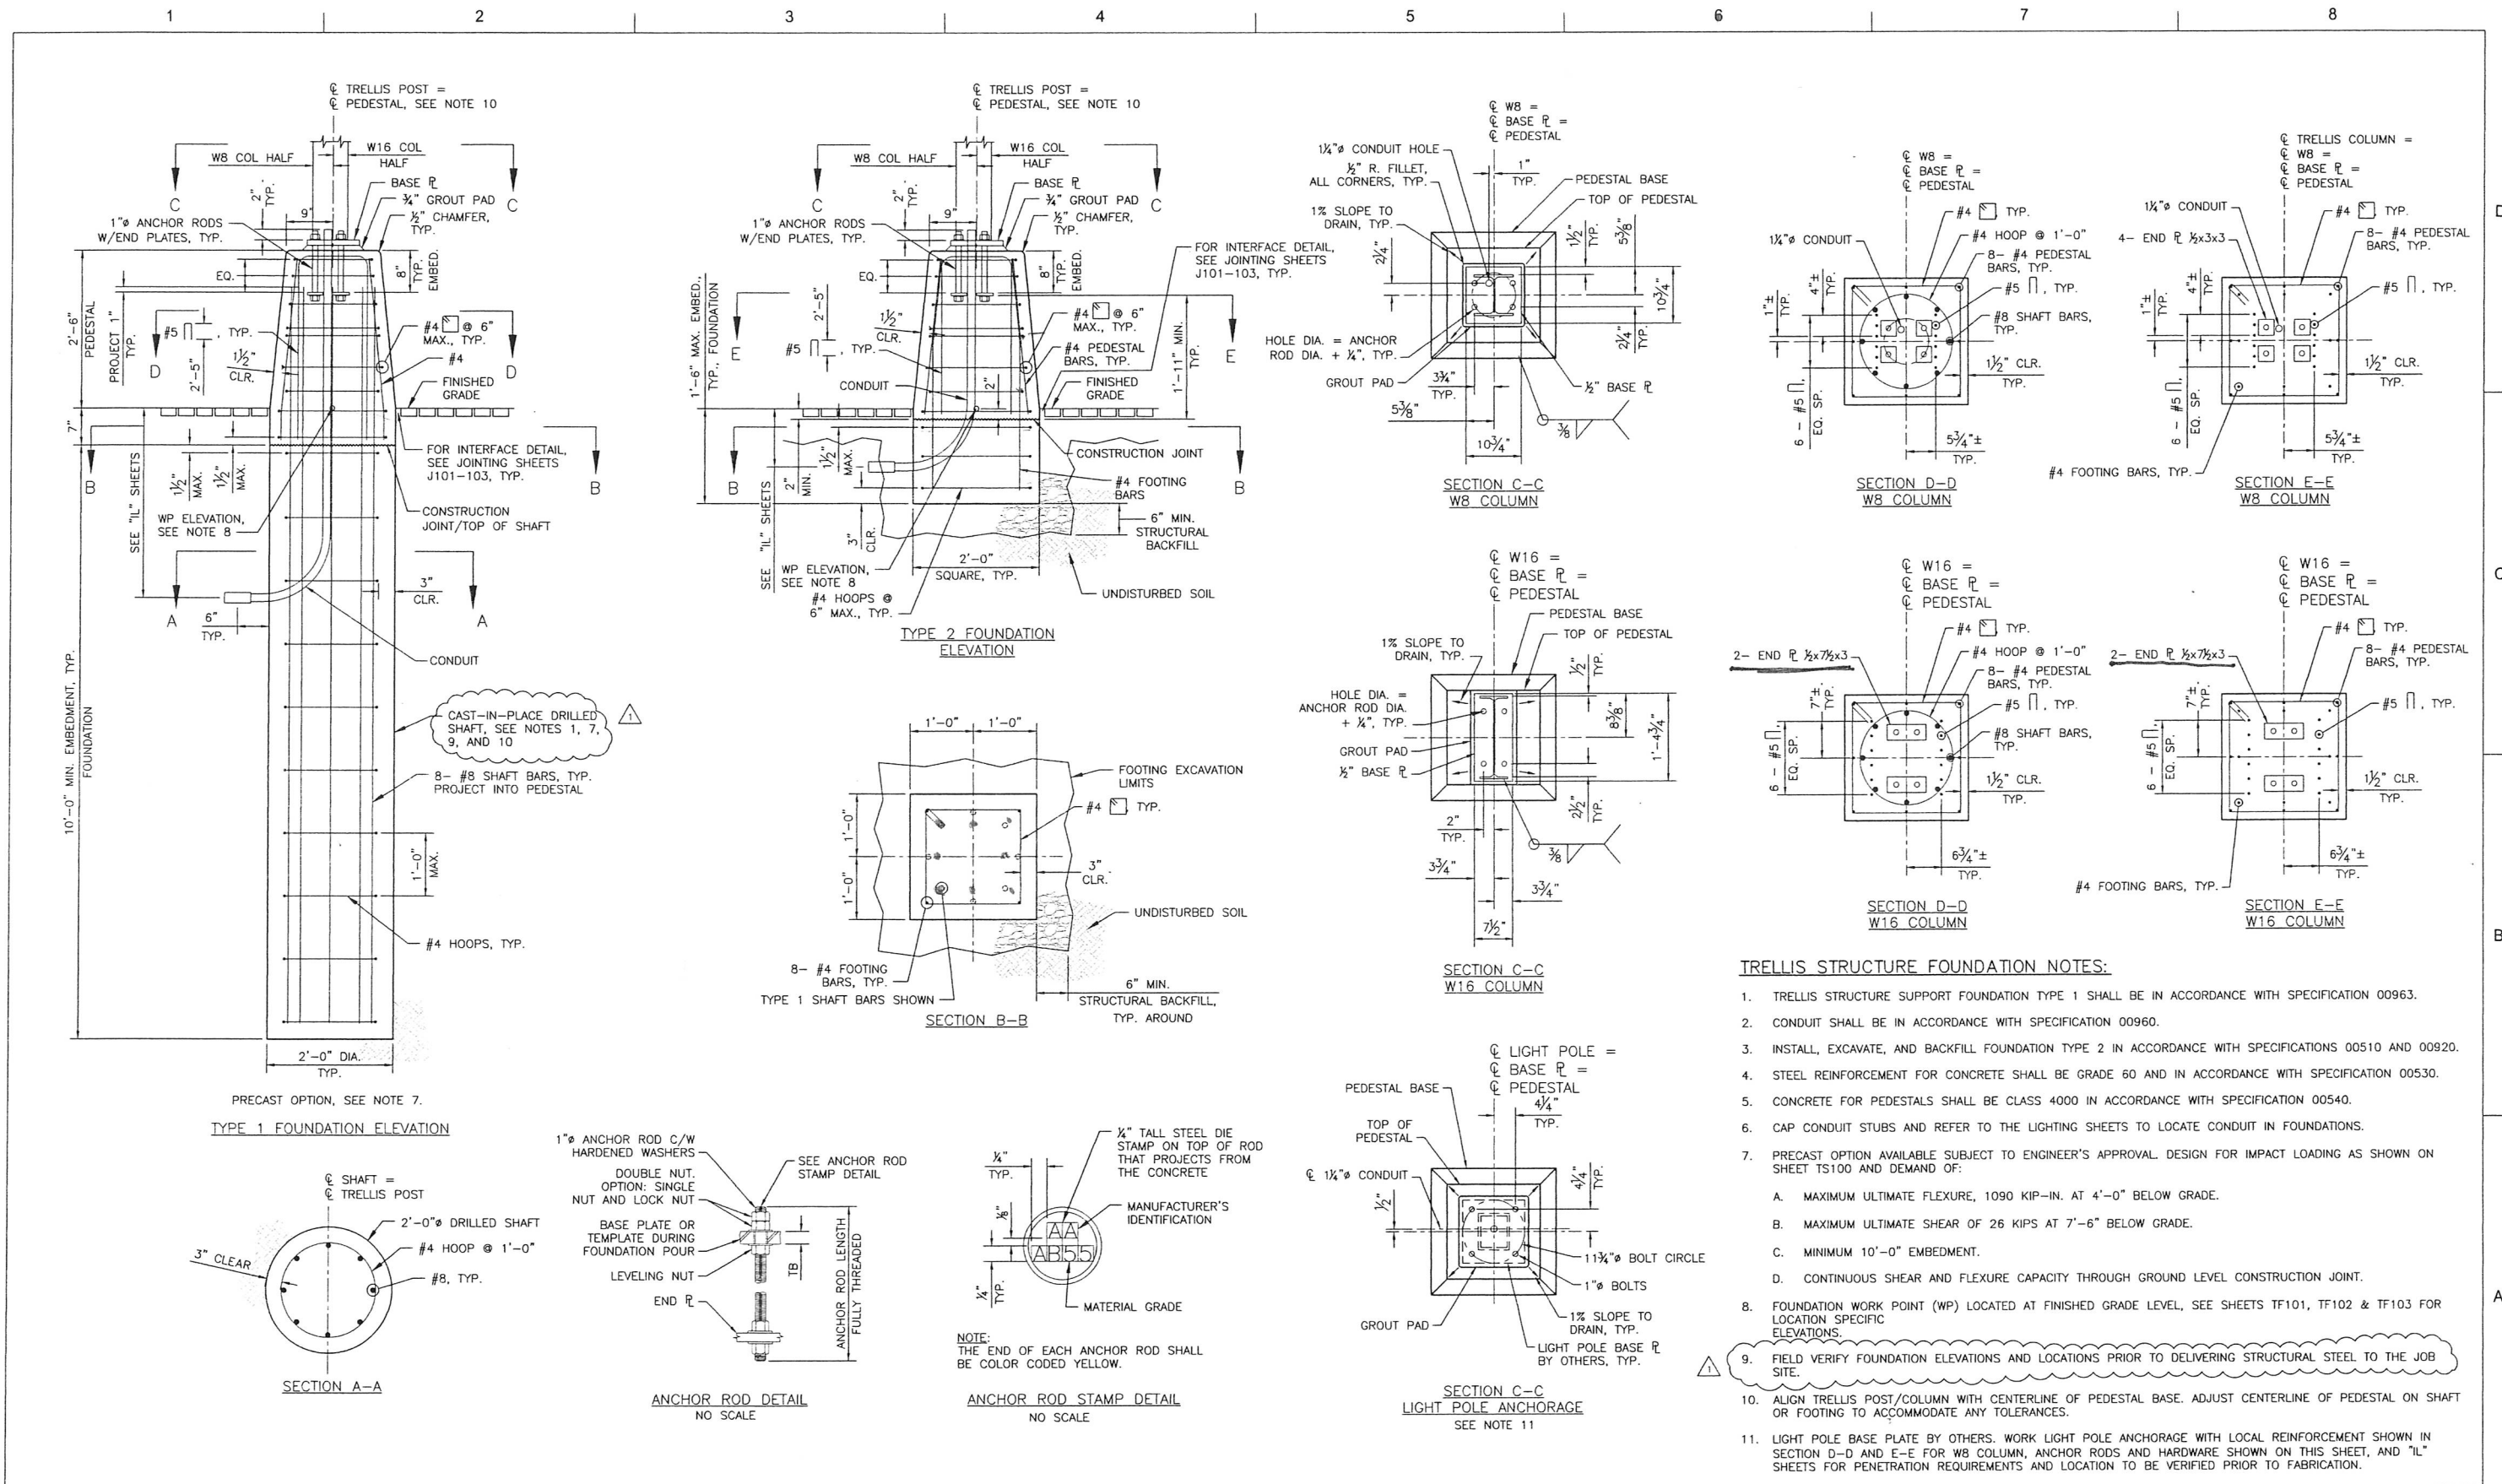

ISSUE	DATE	DESCRIPTION
1	1-26-17	REVISED NOTES

PROJECT MANAGER STEPHANIE SERPICO, P.E.

PROJECT NUMBER 2016-8



CITY OF MCMINNVILLE  
NE ALPINE AVENUE IMPROVEMENTS  
TRELLIS STRUCTURE DETAILS  
NE ALPINE AVENUE

HORIZONTAL SCALE 0 15 30 FEET  
1" = 15'  
DATE 12/2016 SHEET TF301







D

C

B


A

LIGHT POLE TABLE								
POLE NO.	STATION & OFFSET	ARM LENGTH (ft)	LUMINAIRE			MOUNTING HEIGHT (ft)	CIRCUIT NO.	NOTES
			WATTAGE (W)	LINE VOLT	TYPE			
1	199+71.00, 23.00' RT	1'-8 3/4"	90W LED	240V	M-F-III	18'	1A	See TF301 for Type 1 Foundation Detail
2	200+30.99, 23.00' RT	1'-8 3/4"	35W LED	240V	M-F-III	18'	1A	See TF301 for Type 1 Foundation Detail
3	200+31.01, 10.50' LT	1'-8 3/4"	35W LED	240V	M-F-III	18'	1C	See TF301 for Type 1 Foundation Detail
4	201+06.00, 23.00' RT	1'-8 3/4"	35W LED	240V	M-F-III	18'	1A	See TF301 for Type 1 Foundation Detail
5	201+05.93, 20.99' LT	1'-8 3/4"	35W LED	240V	M-F-III	18'	1C	See TF301 for Type 1 Foundation Detail
6	201+92.88, 23.00' RT	1'-8 3/4"	35W LED	240V	M-F-III	18'	1A	See TF301 for Type 1 Foundation Detail
7	201+94.75, 21.00' LT	1'-8 3/4"	35W LED	240V	M-F-III	18'	1C	See TF301 for Type 1 Foundation Detail
8	202+31.99, 30.91' RT	1'-8 3/4"	90W LED	240V	M-F-III	18'	1A	See TF301 for Type 1 Foundation Detail
9	202+77.32, 31.36' LT	1'-8 3/4"	90W LED	240V	M-F-III	18'	1C	See TF301 for Type 1 Foundation Detail
10	203+06.01, 23.00' RT	1'-8 3/4"	35W LED	240V	M-F-III	18'	1A	See TF301 for Type 1 Foundation Detail
11	203+65.07, 23.08' LT	1'-8 3/4"	35W LED	240V	M-F-III	18'	1C	See TF301 for Type 1 Foundation Detail
12	204+26.00, 23.00' RT	1'-8 3/4"	35W LED	240V	M-F-III	18'	1A	See TF301 for Type 1 Foundation Detail
13	204+38.00, 23.00' LT	1'-8 3/4"	35W LED	240V	M-F-III	18'	1C	See TF301 for Type 1 Foundation Detail
14	204+89.04, 19.00' RT	1'-8 3/4"	90W LED	240V	M-F-III	18'	1A	See TF301 for Type 1 Foundation Detail
15	205+51.05, 17.00' LT	1'-8 3/4"	90W LED	240V	M-F-III	18'	1C	See TF301 for Type 1 Foundation Detail
16	205+72.00, 23.00' RT	1'-8 3/4"	35W LED	240V	M-F-III	18'	1A	See TF301 for Type 1 Foundation Detail
17	206+20.02, 23.00' LT	1'-8 3/4"	35W LED	240V	M-F-III	18'	1C	See TF301 for Type 1 Foundation Detail
18	206+97.00, 23.00' RT	1'-8 3/4"	35W LED	240V	M-F-III	18'	1A	See TF301 for Type 1 Foundation Detail
19	207+20.82, 21.00' LT	1'-8 3/4"	35W LED	240V	M-F-III	18'	1C	See TF301 for Type 1 Foundation Detail




ISSUE	DATE	DESCRIPTION

PROJECT MANAGER		STEPHANIE SERPICO, P.E.
PROJECT NUMBER	2016-8	

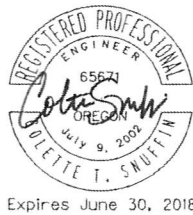

CITY OF MCMINNVILLE  
NE ALPINE AVENUE IMPROVEMENTS  
LIGHT POLE TABLE

HORIZONTAL SCALE  
NO SCALE  
DATE 12/2016

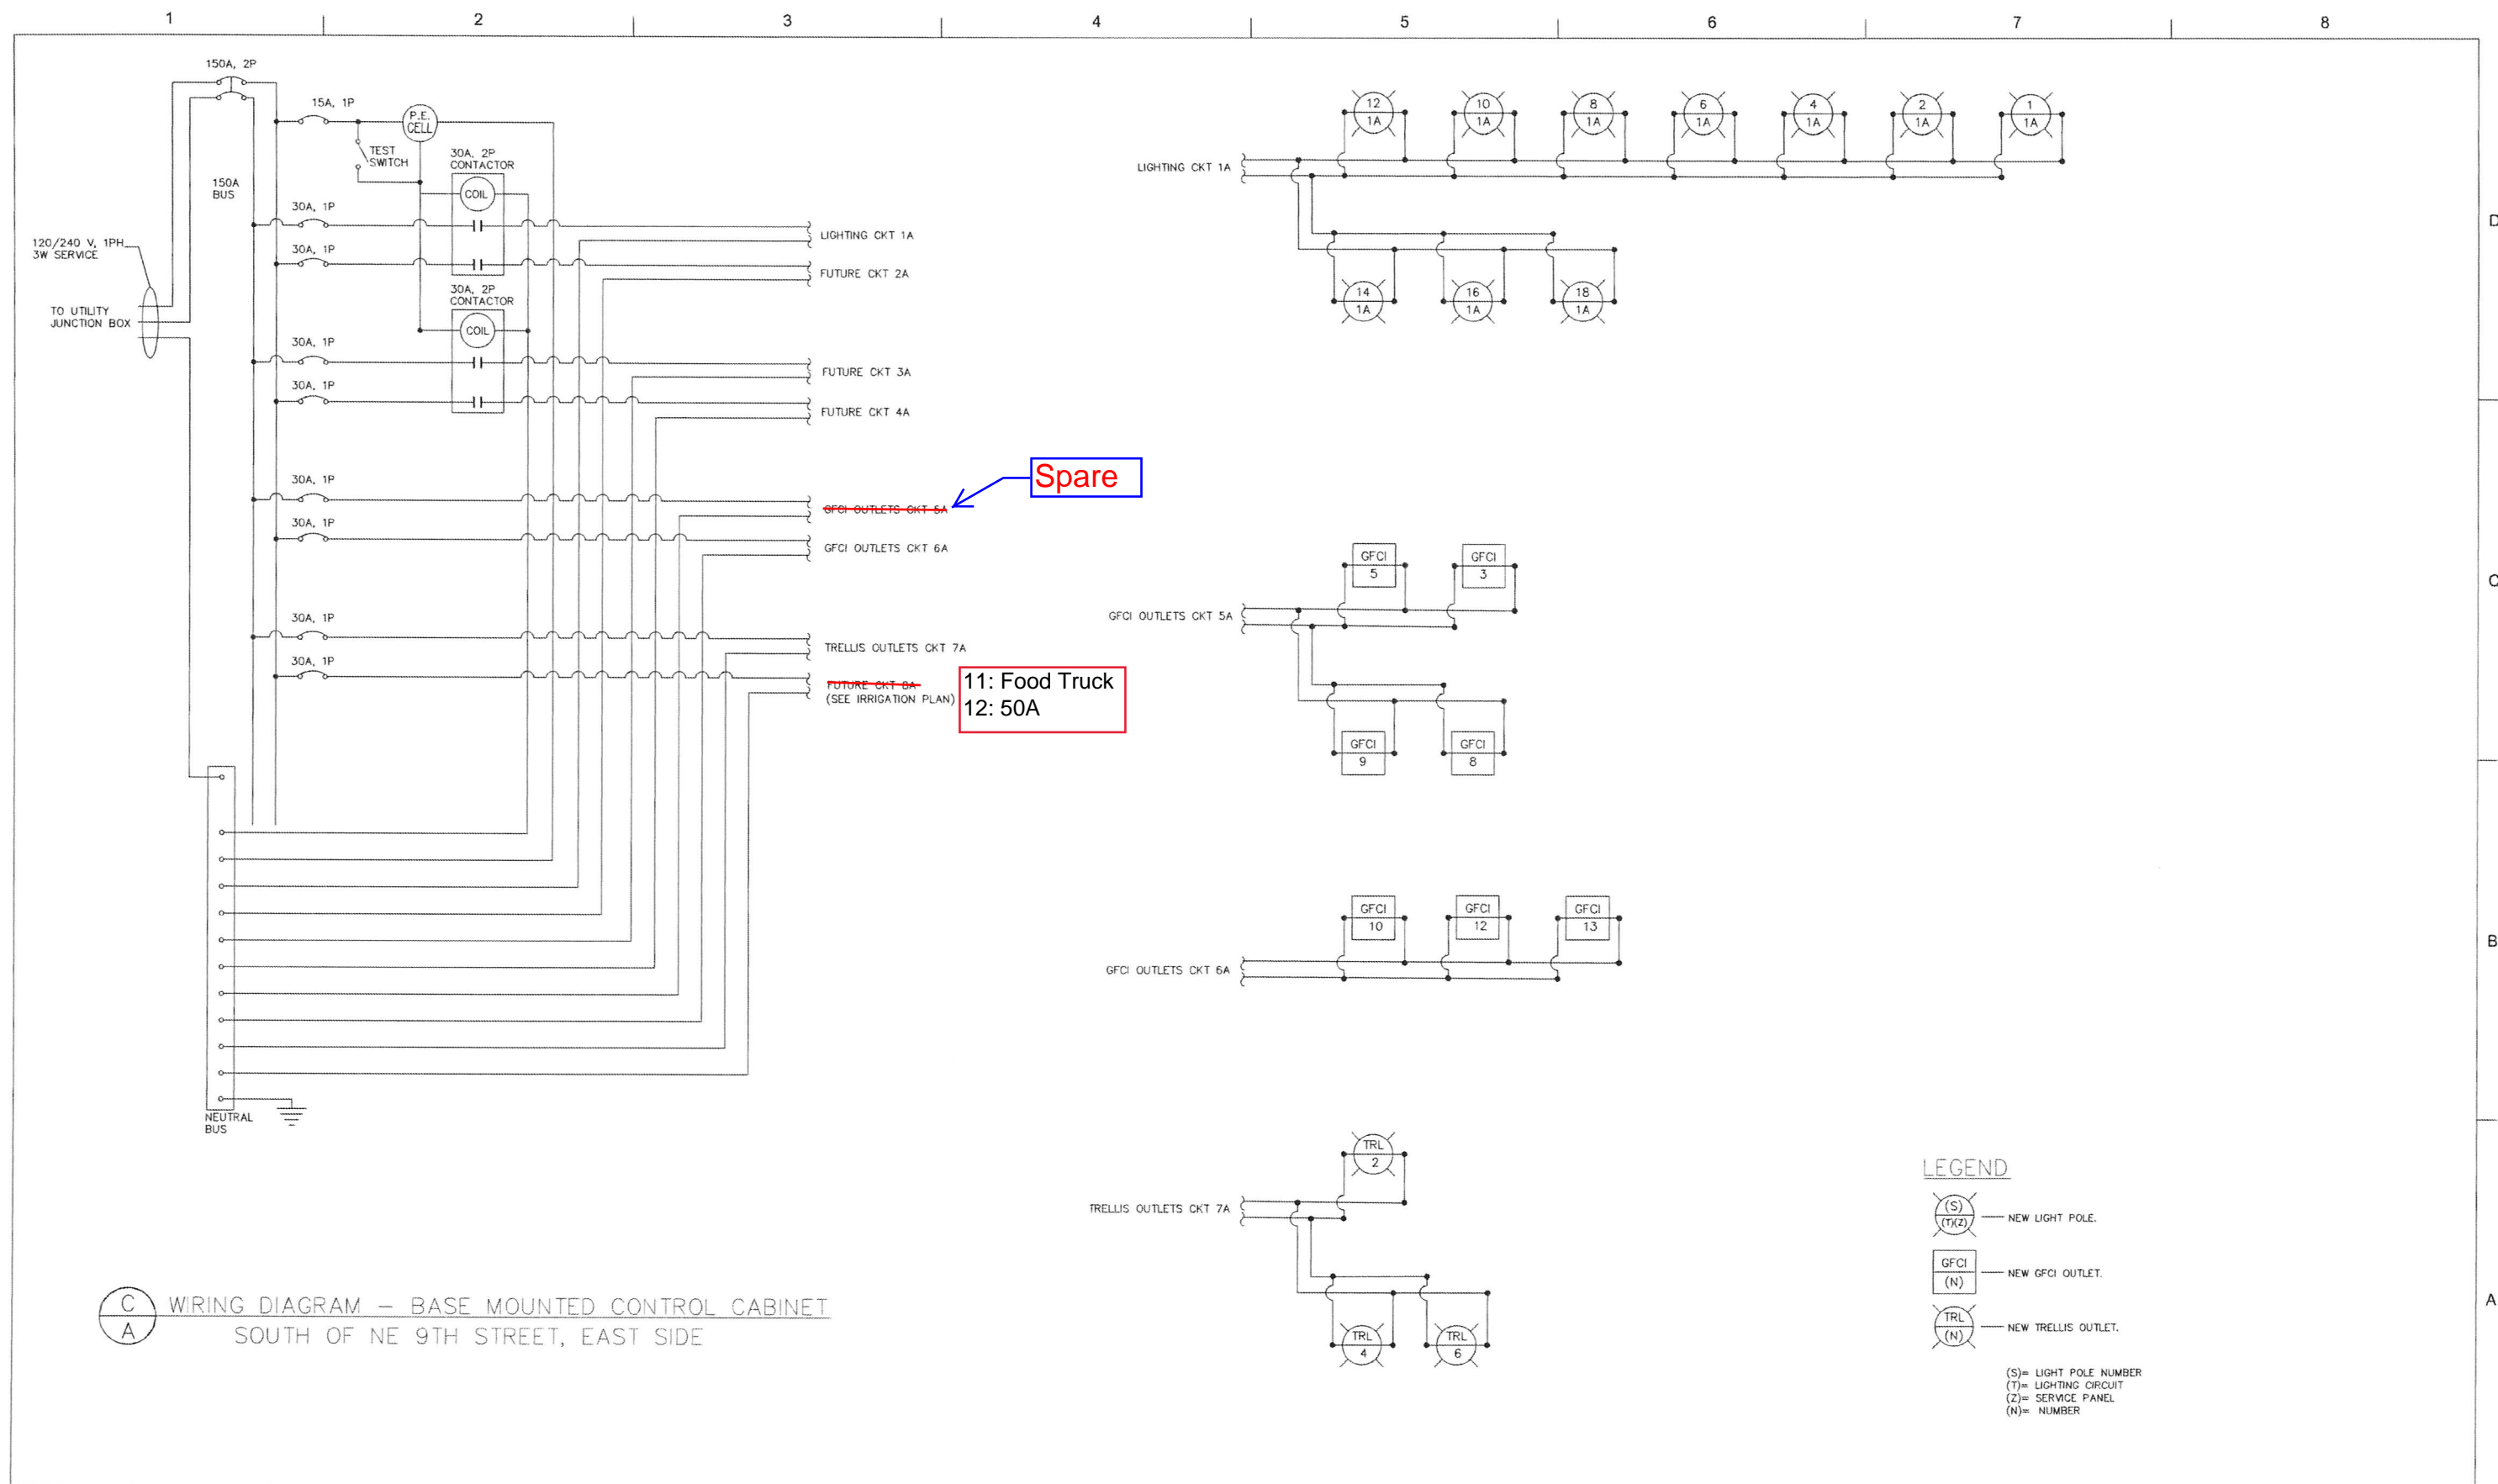

C  
A WIRING DIAGRAM – BASE MOUNTED CONTROL CABINET  
SOUTH OF NE 9TH STREET, EAST SIDE




ISSUE	DATE	DESCRIPTION

PROJECT MANAGER	STEPHANIE SERPICO, P.E.
PROJECT NUMBER	2016-8



CITY OF MCMINNVILLE  
NE ALPINE AVENUE IMPROVEMENTS  
ILLUMINATION DETAILS



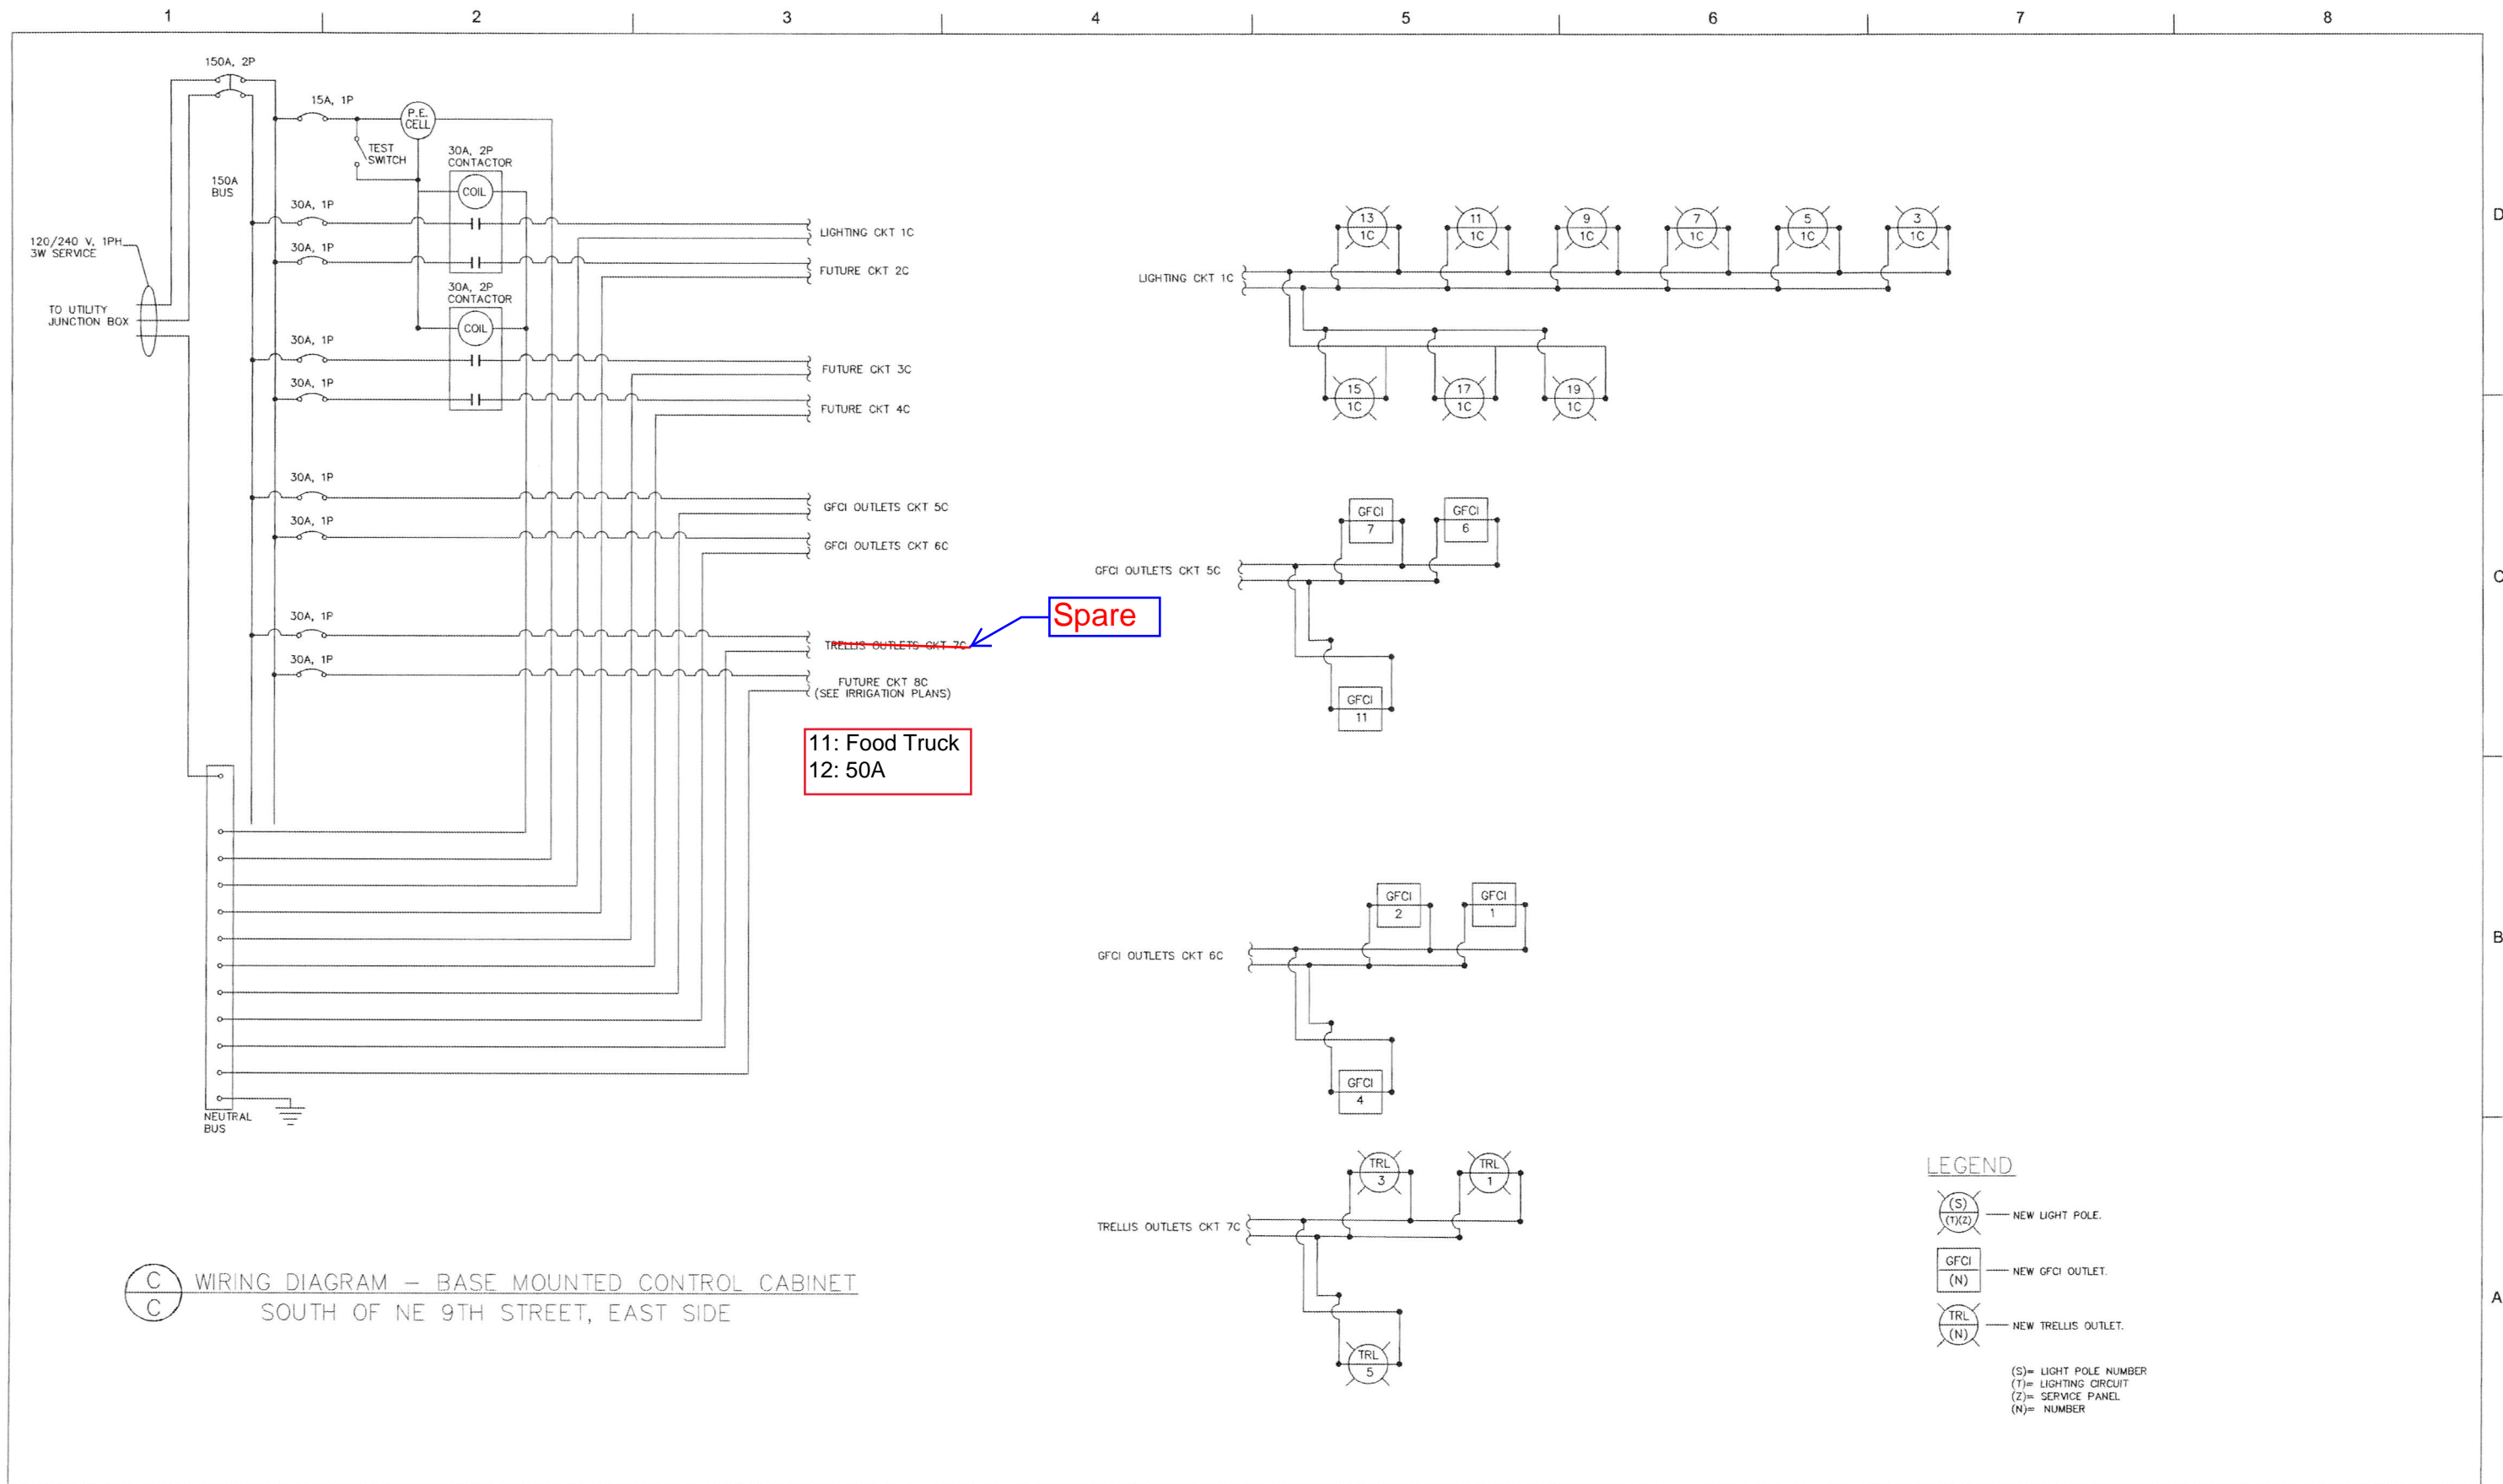

ISSUE	DATE	DESCRIPTION

PROJECT MANAGER	STEPHANIE SERPICO, P.E.
PROJECT NUMBER	2016-8



**CITY OF MCMINNVILLE**  
**NE ALPINE AVENUE IMPROVEMENTS**  
**ILLUMINATION DETAILS**


HORIZONTAL SCALE

NO SCALE

DATE 12/2016

SHEET **IL104**



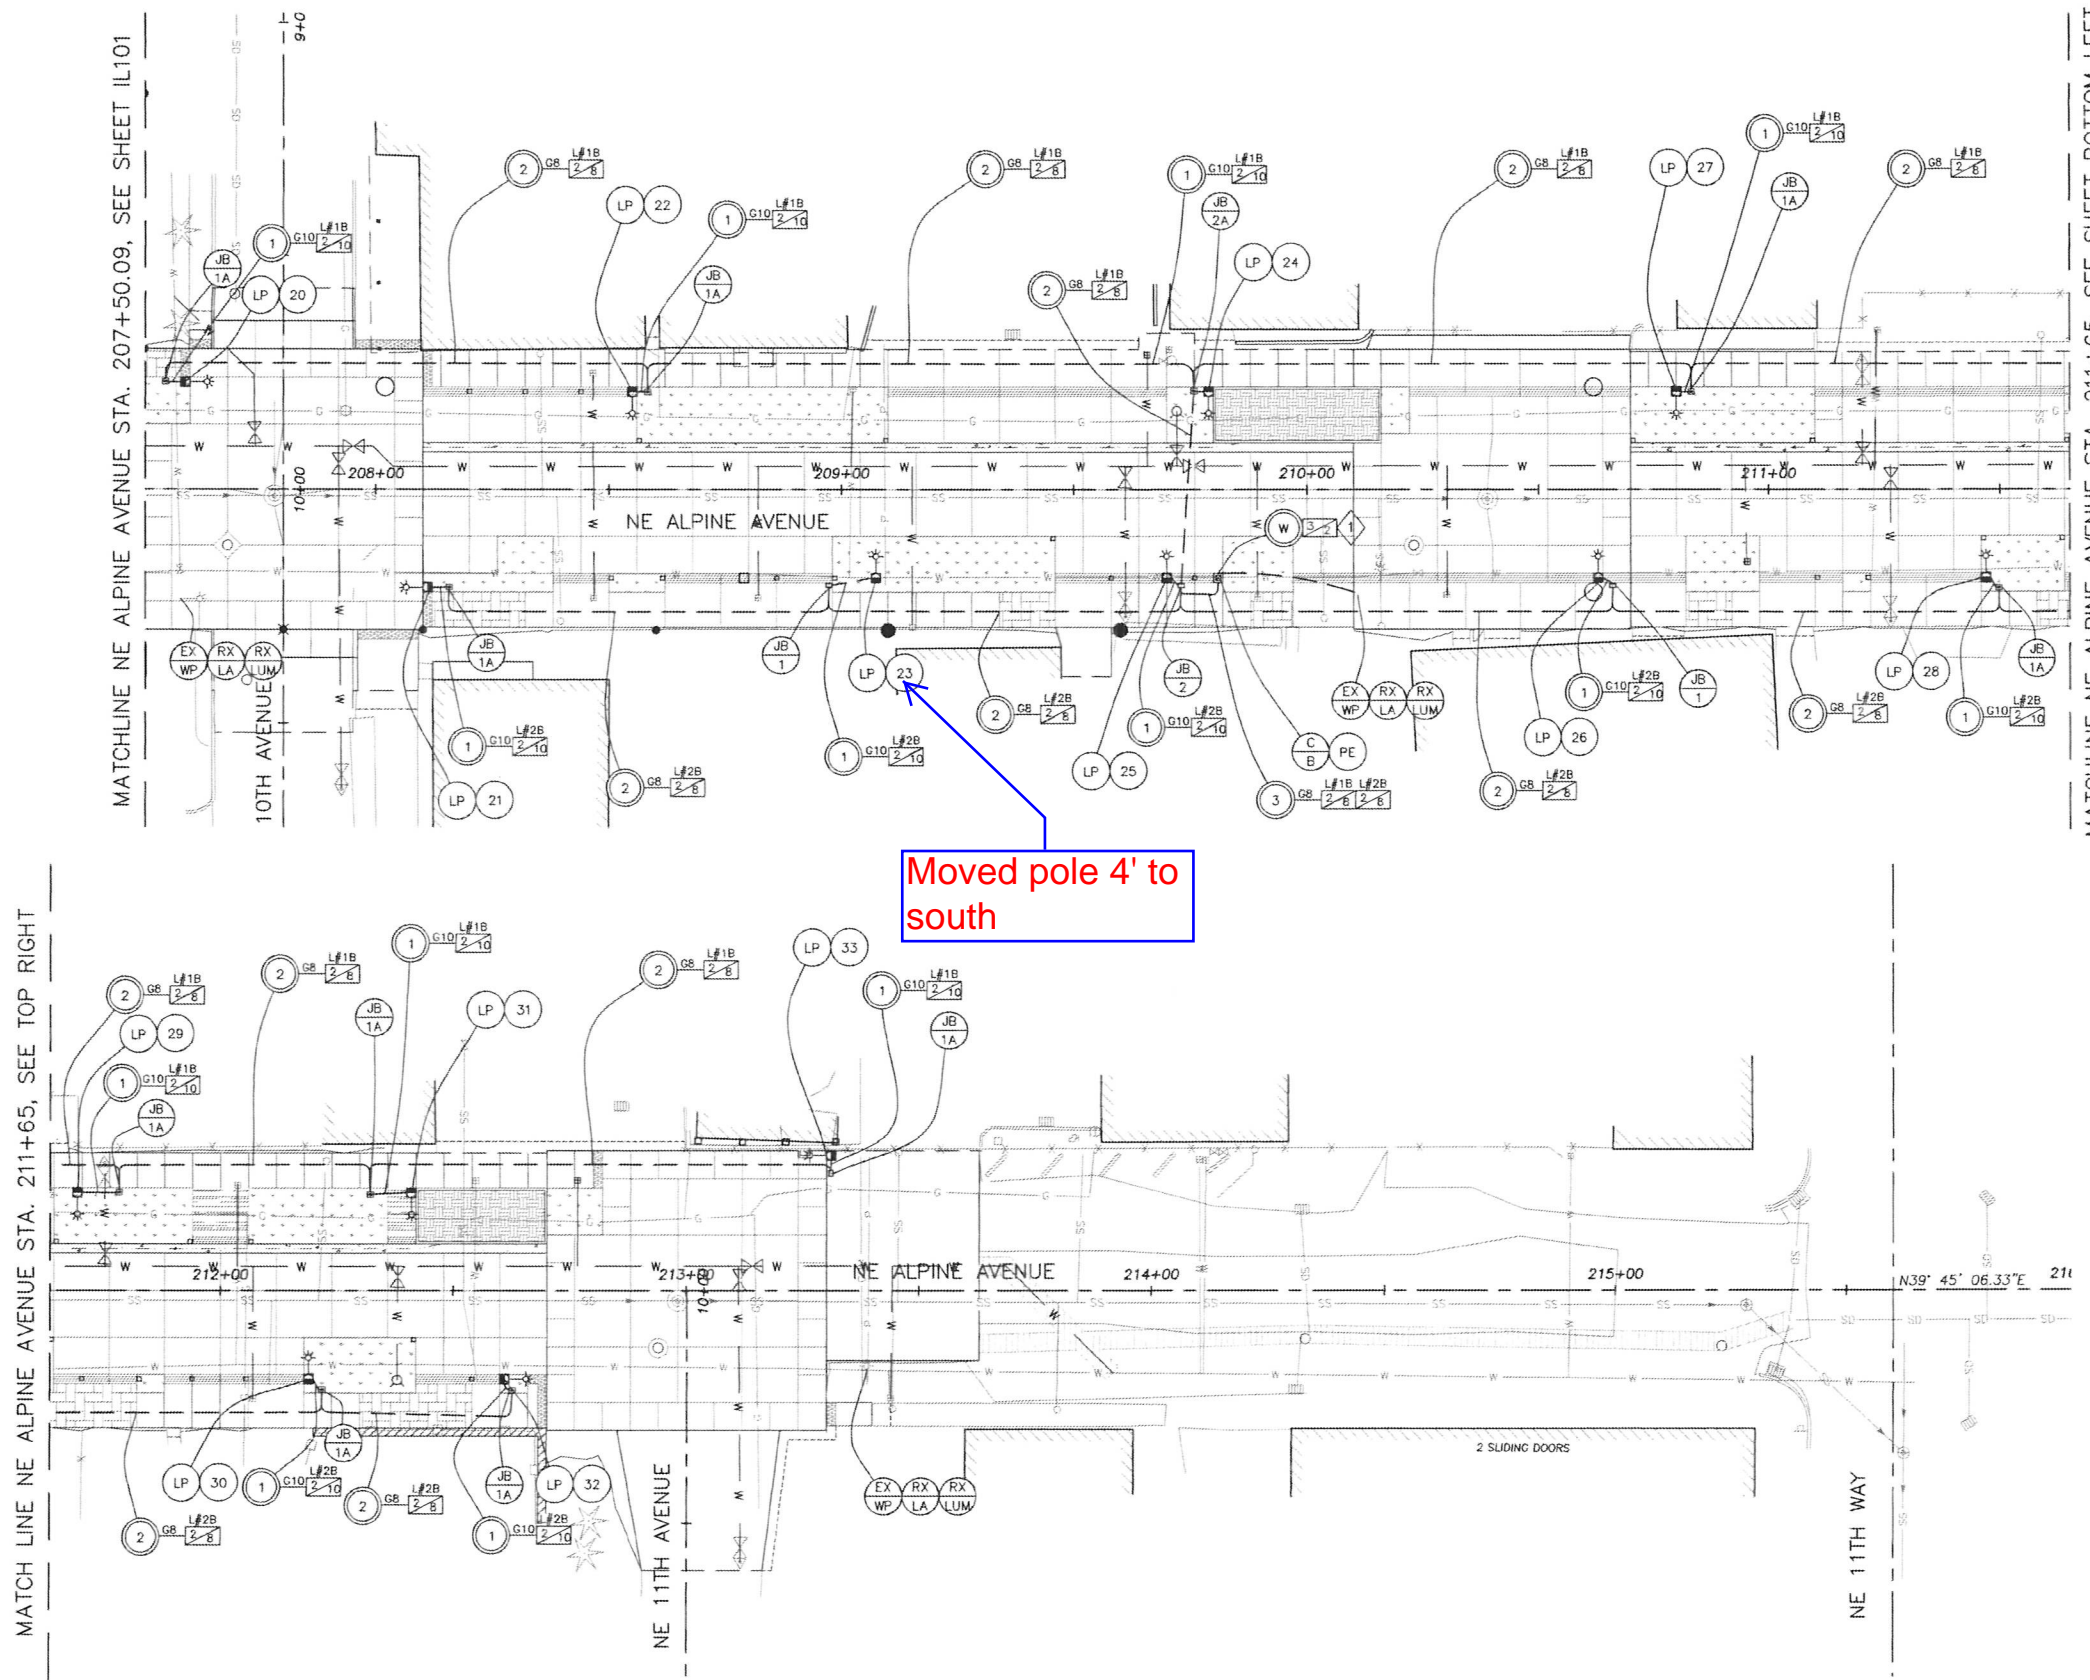

- LEGEND**
- POLES**
- LP INSTALL WOOD LIGHT POLE AND PENDANT STYLE LUMINAIRE FOR ROADWAY ILLUMINATION (SEE LIGHT POLE TABLE)
  - N NEW LIGHT POLE NO. (N) FOR ROADWAY ILLUMINATION (SEE LIGHT POLE TABLE)
  - EX WP MAINTAIN AND PROTECT EXISTING WOOD POLE
- CABINETS**
- C (N) INSTALL BASE MOUNTED CONTROL CABINET NO. (N) (SEE TM485). SEE SHEET IL206 FOR WIRING DIAGRAM.
- JUNCTION BOXES**
- JB 1 INSTALL 17"x10"x12" (MIN. DIMENSION) PRECAST CONCRETE JUNCTION BOX.
  - JB 1A INSTALL 17"x10"x12" (MIN. DIMENSION) PRECAST CONCRETE JUNCTION BOX WITH CONCRETE APRON.
  - JB 2 INSTALL 22" X 12" X 12" (MIN. DIMENSION) PRECAST CONCRETE JUNCTION BOX.
  - JB 2A INSTALL 22" X 12" X 12" (MIN. DIMENSION) PRECAST CONCRETE JUNCTION BOX WITH CONCRETE APRON.
- CONDUITS**
- S INSTALL (S = SIZE) INCH CONDUIT
  - W INSTALL (W = SIZE) INCH CONDUIT PER UTILITY REQUIREMENTS
- LUMINAIRES**
- RX LUM REMOVE EXISTING LUMINAIRE, BY OTHERS. COORDINATE WITH MCMINNVILLE WATER AND LIGHT.
  - RX LA REMOVE EXISTING LUMINAIRE ARM, BY OTHERS. COORDINATE WITH MCMINNVILLE WATER AND LIGHT.
- WIRES & CABLES**
- N S INSTALL COPPER ELECTRICAL CONDUCTORS (N= NUMBER OF CONDUCTORS, S=SIZE OF CONDUCTORS).
  - L#NZ ROADWAY ILLUMINATION CIRCUIT NO. (N) FROM CONTROL CABINET (Z)
  - G# INSTALL GREEN INSULATED GROUND WIRE (# = AWG SIZE)
- MISCELLANEOUS**
- EX I RETAIN AND PROTECT EXISTING POWER POLE (POWER SOURCE)
  - PE INSTALL PHOTO CONTROL. SEE SHEET IL301 FOR DETAILS
- CONSTRUCTION NOTES**
- 1 COORDINATE POWER SERVICE CONNECTION WITH MCMINNVILLE WATER AND LIGHT.
- NOTE:  
ALL CONDUIT WILL BE COMPACTED WITH AGGREGATE BACKFILL PER SPECIFICATION SECTION 00405.



PROJECT MANAGER STEPHANIE SERPICO, P.E.		
ISSUE	DATE	DESCRIPTION
PROJECT NUMBER	2016-8	



CITY OF MCMINNVILLE  
NE ALPINE AVENUE IMPROVEMENTS  
ADD ALTERNATIVE LIGHTING PLAN  
NE ALPINE AVENUE STA: 207+50.09 TO 215+95.00



HORIZONTAL SCALE 0 20 40 FEET  
1" = 20'  
DATE 12/2016 SHEET IL205

D

C

B

A

LIGHT POLE TABLE								
POLE NO.	STATION & OFFSET	ARM LENGTH (ft)	LUMINAIRE			MOUNTING HEIGHT (ft)	CIRCUIT NO.	NOTES
			WATTAGE (W)	LINE VOLT	TYPE			
20	207+59.00, 23.00' LT	1'-8 3/4"	90W LED	240V	M-F-III	18'	1B	See TF301 for Type 1 Foundation Detail
21	208+11.09, 21.00' RT	1'-8 3/4"	90W LED	240V	M-F-III	18'	2B	See TF301 for Type 1 Foundation Detail
22	208+55.00, 21.00' LT	1'-8 3/4"	35W LED	240V	M-F-III	18'	1B	See TF301 for Type 1 Foundation Detail
23	209+07.39, 19.00' RT	1'-8 3/4"	35W LED	240V	M-F-III	18'	2B	See TF301 for Type 1 Foundation Detail
24	209+79.00, 21.00" LT	1'-8 3/4"	35W LED	240V	M-F-III	18'	1B	See TF301 for Type 1 Foundation Detail
25	209+70.00, 19.00' RT	1'-8 3/4"	35W LED	240V	M-F-III	18'	2B	See TF301 for Type 1 Foundation Detail
26	210+63.00, 19.00' RT	1'-8 3/4"	35W LED	240V	M-F-III	18'	2B	See TF301 for Type 1 Foundation Detail
27	210+80.00, 21.00' LT	1'-8 3/4"	35W LED	240V	M-F-III	18'	1B	See TF301 for Type 1 Foundation Detail
28	211+47.00, 19.00' RT	1'-8 3/4"	35W LED	240V	M-F-III	18'	2B	See TF301 for Type 1 Foundation Detail
29	211+69.00, 21.00' LT	1'-8 3/4"	35W LED	240V	M-F-III	18'	1B	See TF301 for Type 1 Foundation Detail
30	212+19.00, 19.00' RT	1'-8 3/4"	35W LED	240V	M-F-III	18'	2B	See TF301 for Type 1 Foundation Detail
31	212+41.00, 21.00' LT	1'-8 3/4"	35W LED	240V	M-F-III	18'	1B	See TF301 for Type 1 Foundation Detail
32	212+61.00, 19.00' RT	1'-8 3/4"	90W LED	240V	M-F-III	18'	2B	See TF301 for Type 1 Foundation Detail
33	213+31.10, 29.00' LT	1'-8 3/4"	90W LED	240V	M-F-III	18'	1B	See TF301 for Type 1 Foundation Detail



ISSUE	DATE	DESCRIPTION

PROJECT MANAGER		STEPHANIE SERPICO, P.E.
PROJECT NUMBER	2016-8	



Expires June 30, 2018

CITY OF MCMINNVILLE  
NE ALPINE AVENUE IMPROVEMENTS  
ADD ALTERNATIVE LIGHT POLE TABLE

HORIZONTAL SCALE



NO SCALE

DATE 12/2016

SHEET

IL206



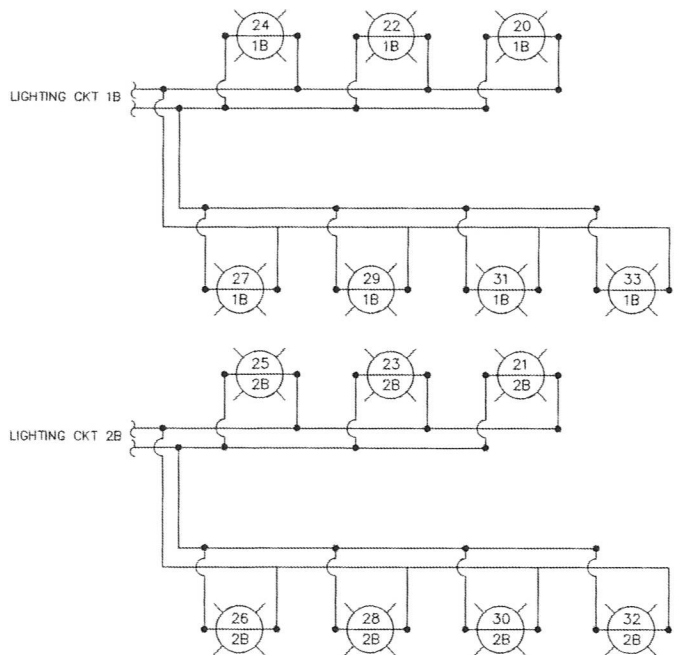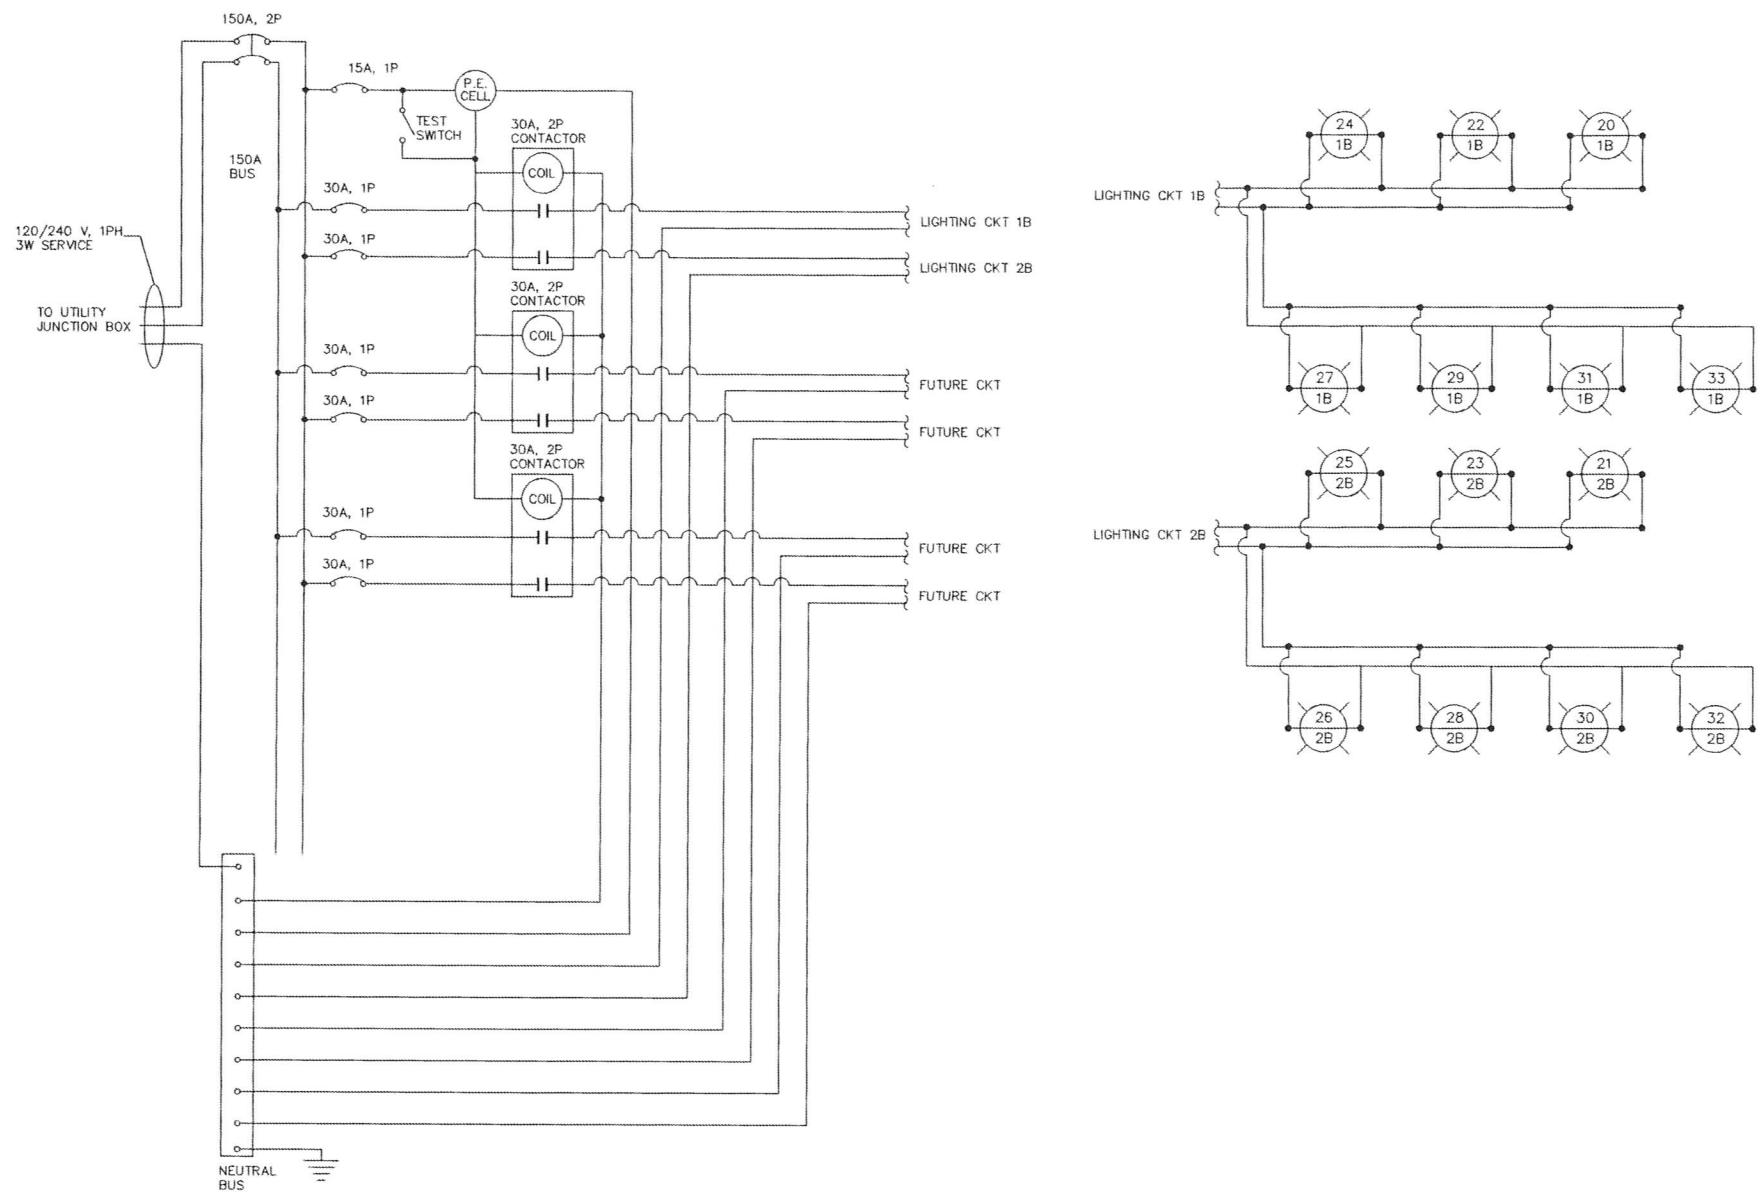

C WIRING DIAGRAM - BASE MOUNTED CONTROL CABINET  
B NORTH OF NE 10TH AVENUE, EAST SIDE

LEGEND  
(S) - NEW LIGHT POLE.  
(S) = LIGHT POLE NUMBER  
(T) = LIGHTING CIRCUIT  
(Z) = SERVICE PANEL



ISSUE	DATE	DESCRIPTION

PROJECT MANAGER	STEPHANIE SERPICO, P.E.
PROJECT NUMBER	2016-8




CITY OF MCMINNVILLE  
NE ALPINE AVENUE IMPROVEMENTS  
ADD ALTERNATIVE ILLUMINATION DETAILS

HORIZONTAL SCALE NO SCALE  
DATE 12/2016 SHEET IL207




1 2 3 4 5 6 7 8

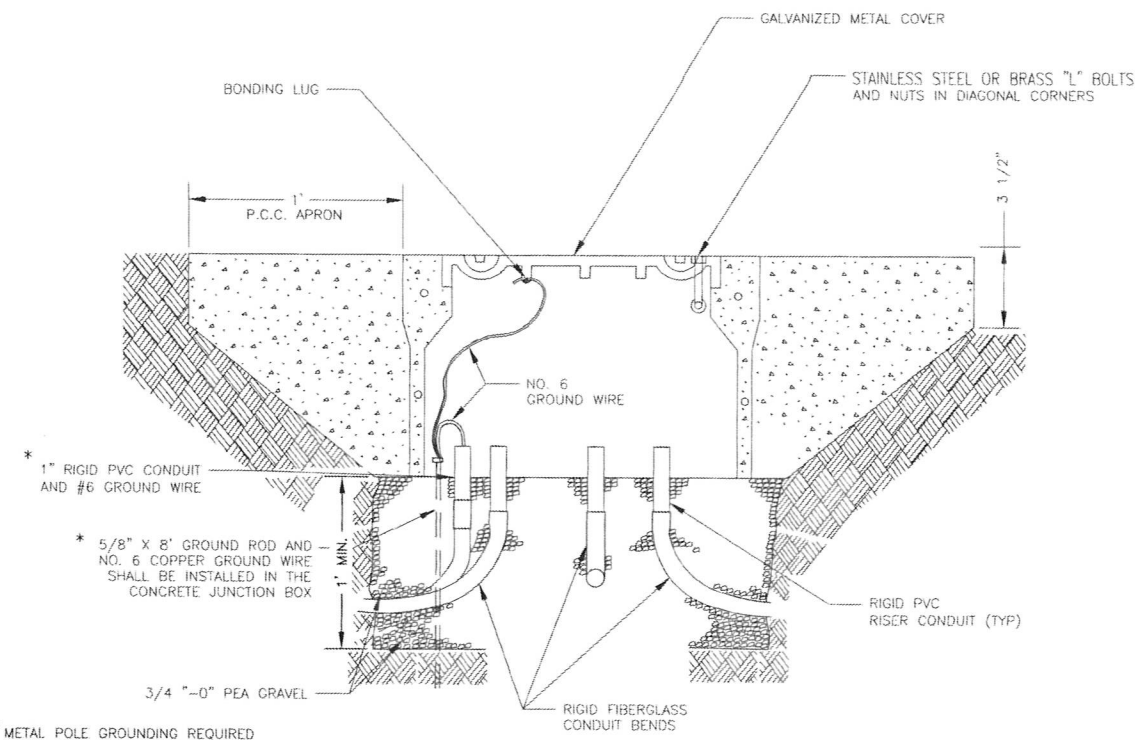

CONCRETE JUNCTION BOX INSTALLATION WITH APRON (NEAR ILLUM. POLE)

- NOTE
1. ILLUMINATION CIRCUIT WIRES ARE NOT SHOWN. SEE ILLUMINATION PLANS.
  2. ILLUMINATION CIRCUITS SHALL BE SPLICED ACCORDING TO SECTION 02920.25
  3. POLYMER CONCRETE JUNCTION BOX COVER, IF USED, IS NOT REQUIRED TO BE BONDED.
  4. METALLIC CONDUIT, IF USED, SHALL BE BONDED AND CONNECTED TO CIRCUIT GROUND WIRES.

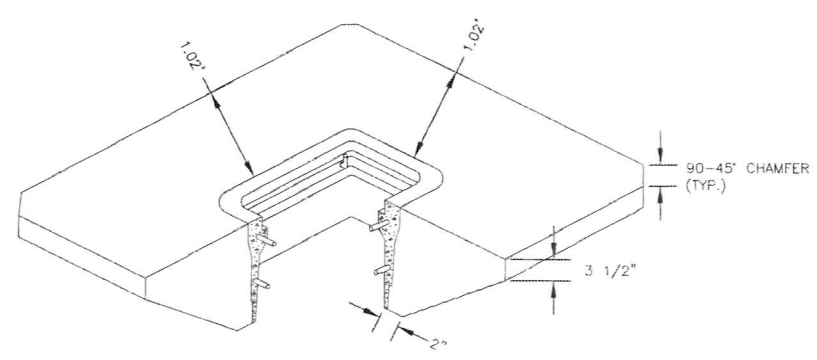

CONCRETE APRON AROUND JUNCTION BOX  
(APPROX. 7FT<sup>3</sup> CONCRETE IN NEAT SECTION)



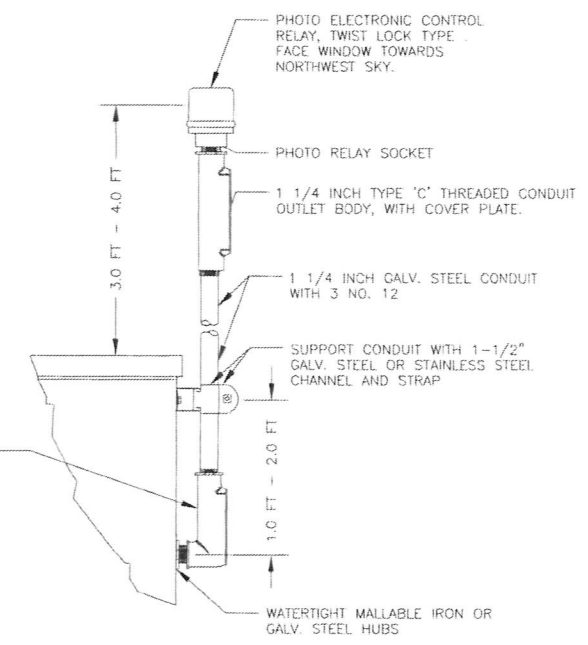


PHOTO CONTROL INSTALLATION  
SIDE OF PAD MOUNT CABINET

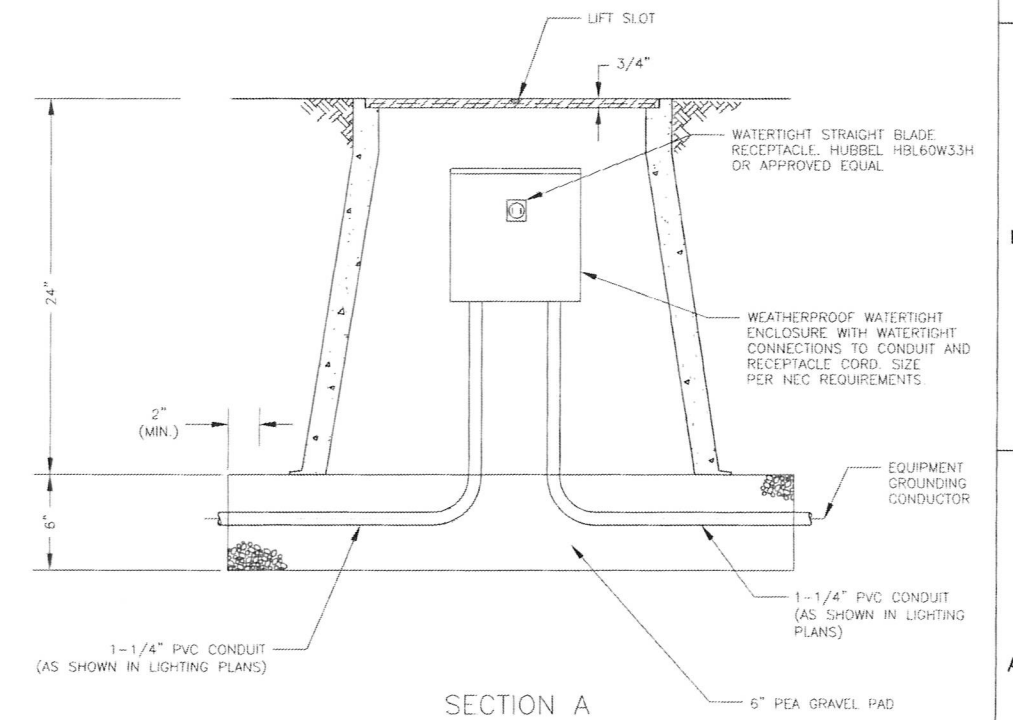

JUNCTION BOX AND GFI RECEPTACLE DETAIL  
(NTS)

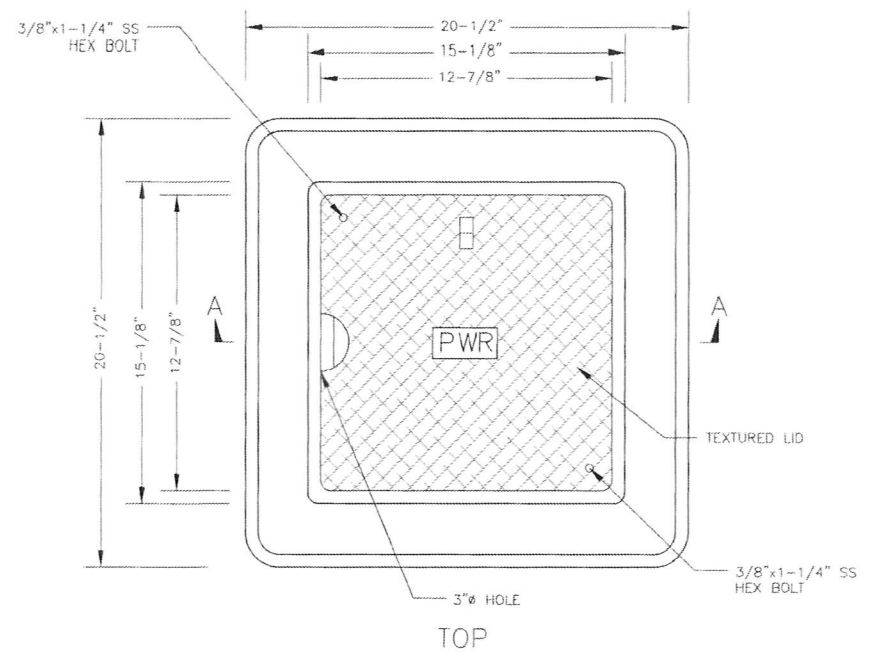


			PROJECT MANAGER STEPHANIE SERPICO, P.E.	
ISSUE	DATE	DESCRIPTION	PROJECT NUMBER	2016-8



CITY OF MCMINNVILLE  
NE ALPINE AVENUE IMPROVEMENTS  
ILLUMINATION DETAILS

HORIZONTAL SCALE  
NO SCALE  
DATE 12/2016  
SHEET IL301

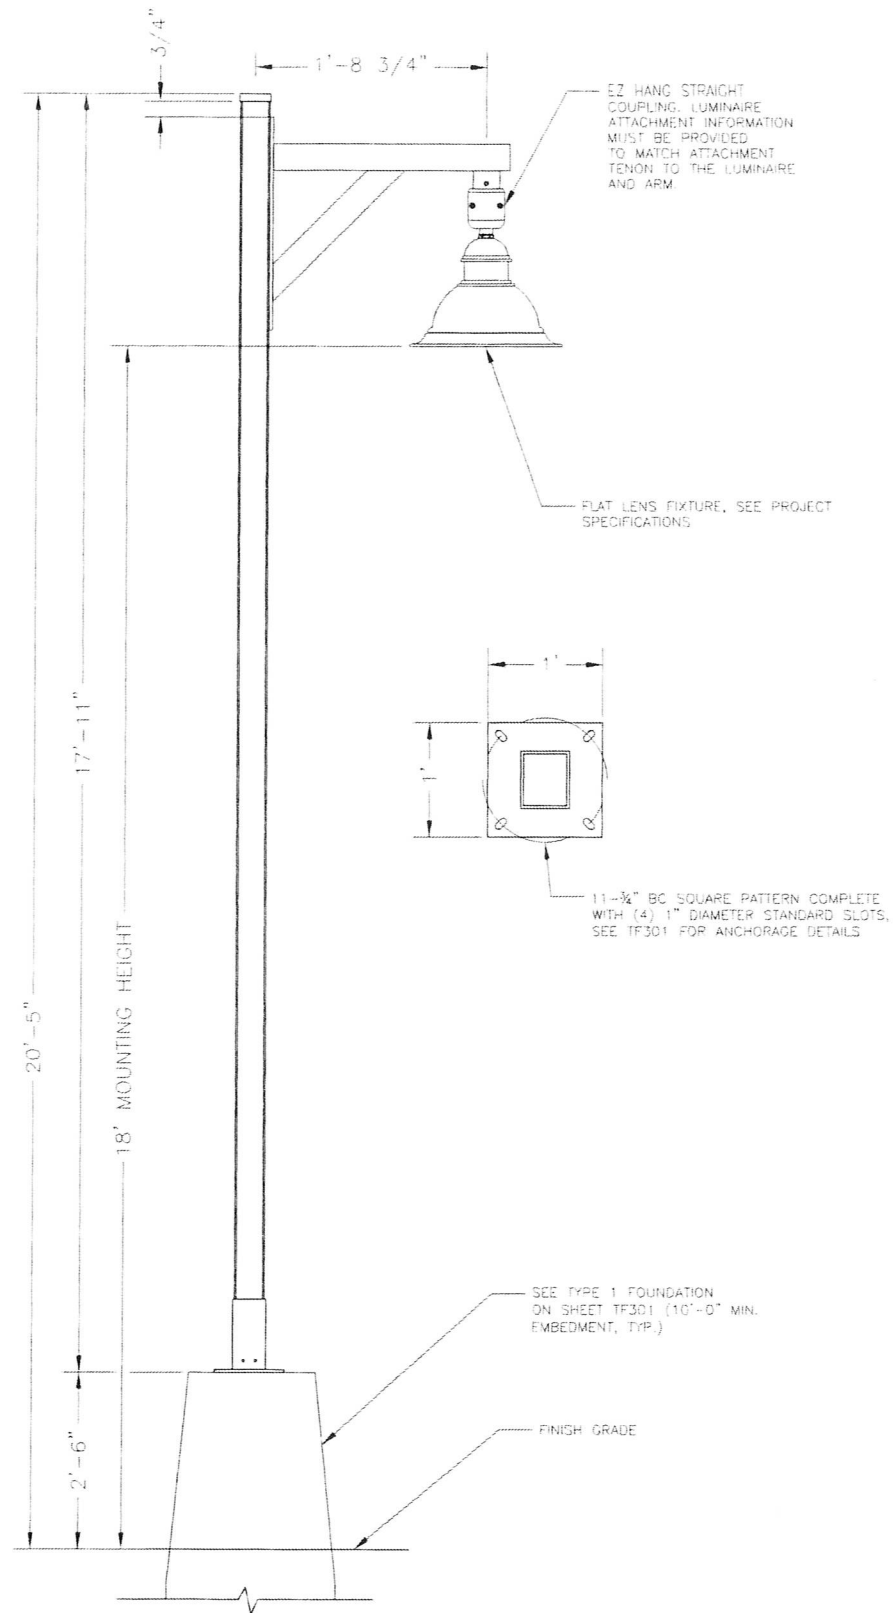

LIGHT POLE DETAIL



ISSUE	DATE	DESCRIPTION

PROJECT MANAGER	STEPHANIE SERPICO, P.E.
PROJECT NUMBER	2016-8



Expires June 30, 2018

CITY OF MCMINNVILLE  
NE ALPINE AVENUE IMPROVEMENTS  
ILLUMINATION DETAILS

HORIZONTAL SCALE  
NO SCALE  
DATE 12/2016

SHEET IL302